

STATE ENGINEER  
Salem, Oregon

WASH  
4811

# Well Record

STATE WELL NO. 1N/1W-28E  
COUNTY Washington  
APPLICATION NO. GR-1293

GR- 1250

OWNER: Lindow Bros.


MAILING ADDRESS: 3160 NW 143 rd.

LOCATION OF WELL: Owner's No.

CITY AND STATE: Portland 1, Oregon

SW 1/4 NW 1/4 Sec. 28 T. 1 N. E. S. R. 1 W., W.M.

Bearing and distance from section or subdivision corner 1920' S. & 1250' E. from NW cor., Sec. 28.

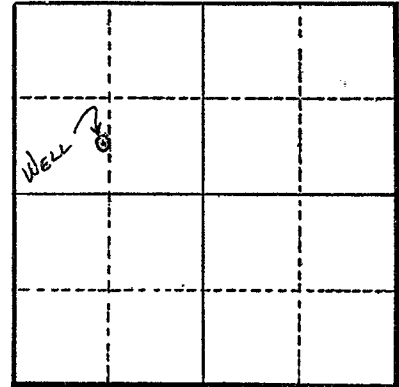

Section 28

Altitude at well 208 ft.

TYPE OF WELL: Drilled Date Constructed 1951

Depth drilled 580 ft. Depth cased 480 ft.

### CASING RECORD:

12 inch from 0 to 480 ft.

### FINISH:

### AQUIFERS:

### WATER LEVEL:

Flowing 80 GPM on April 1952 - Shut in pressure 20 lbs. per sq. in.

PUMPING EQUIPMENT: Type 17 stage turbine H.P. 30

Capacity 250 G.P.M.

### WELL TESTS:

Drawdown 250 ft. after 250 hours G.P.M.

Drawdown ft. after hours G.P.M.

USE OF WATER Irrigation Temp. °F. 19

SOURCE OF INFORMATION G. R. Record

DRILLER or DIGGER Strayor & Barron

### ADDITIONAL DATA:

Log Water Level Measurements Chemical Analysis Aquifer Test

### REMARKS:

Log: Clay 0 to 480 ft.  
Basalt 480 to 580 ft.

Irrigation of 74.4 acres.