

STATE ENGINEER
Salem, Oregon

WASH
4898

Well Record

GR- 1244


STATE WELL NO. 1N/1W-31(2)
COUNTY Washington
APPLICATION NO. GR. 1287

OWNER: Peter Streiff
MAILING ADDRESS: 17835 NW Walker Rd.

LOCATION OF WELL: Owner's No. _____
CITY AND STATE: Aloha, Oregon

NE 1/4 SW 1/4 Sec. 31 T. 1 N. R. 1 E. W., W.M.

Bearing and distance from section or subdivision
corner 460' S. & 896' W. from SE cor. of the SE 1/4
of the NW 1/4 of Sec. 31.

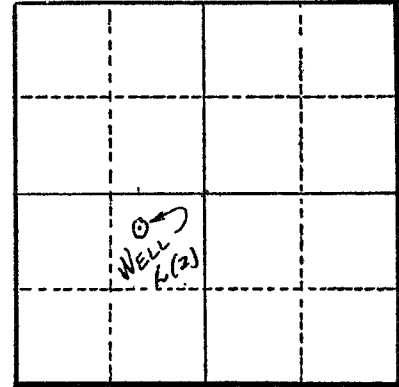

Section 31

Altitude at well 200 ft.

TYPE OF WELL: Drilled Date Constructed 1947

Depth drilled 135 ft. Depth cased 135 ft.

CASING RECORD:
6 inch

FINISH:

AQUIFERS:

WATER LEVEL:
40 ft.

PUMPING EQUIPMENT: Type Goulds jet H.P. 1
Capacity 5 G.P.M.

WELL TESTS:
Drawdown _____ ft. after _____ hours G.P.M.
Drawdown _____ ft. after _____ hours G.P.M.

USE OF WATER Irrigation Temp. °F. 19

SOURCE OF INFORMATION G. R. Record

DRILLER or DIGGER N. N. Janssen

ADDITIONAL DATA:
Log N.A. Water Level Measurements Chemical Analysis Aquifer Test

REMARKS:

Irrigation of 2 acres.