

STATE ENGINEER  
Salem, Oregon

WASH  
4934

# Well Record

STATE WELL NO. 1N/1W-34K  
COUNTY WASHINGTON  
APPLICATION NO. GR-2682

OWNER: Lester Clark


MAILING ADDRESS: 550 NW 114th St

LOCATION OF WELL: Owner's No.

CITY AND STATE: Portland, Oregon

NW 1/4 SE 1/4 Sec. 34 T. 1 N. 6, R. 1 W., W.M.

Bearing and distance from section or subdivision corner 1400' N & 600' E from S 1/4 cor Sec 34

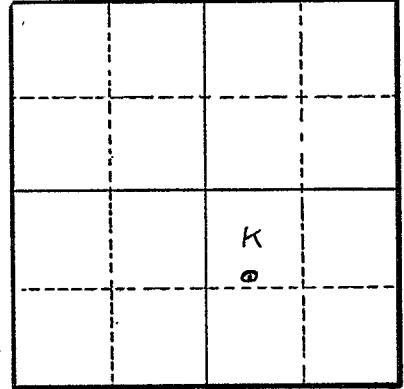

Altitude at well

TYPE OF WELL: Drilled Date Constructed 1951

Depth drilled 93' Depth cased 75'

Section 34

### CASING RECORD:

8-inch

### FINISH:

15 perforations 3/8" wide x 1 1/4" long

69' to 72'

### AQUIFERS:

### WATER LEVEL:

72'

PUMPING EQUIPMENT: Type Pacific submersable

H.P. 1 1/2

Capacity 15 G.P.M.

### WELL TESTS:

Drawdown 72 ft. after 20 hours G.P.M.

Drawdown ft. after hours G.P.M.

USE OF WATER Irrigation Temp. °F., 19

SOURCE OF INFORMATION GR-3957

DRILLER or DIGGER A. N. Jansen

### ADDITIONAL DATA:

Log  Water Level Measurements  Chemical Analysis  Aquifer Test

### REMARKS:

