

STATE ENGINEER
Salem, Oregon

WASH
4950

Well Record

STATE WELL NO. 1N/1W 34(1)
COUNTY Washington
APPLICATION NO. GR-949

OWNER: Alfred Teifel


MAILING ADDRESS: 11414 N.W. CORNELL RD.

LOCATION OF WELL: Owner's No.

CITY AND STATE: PORTLAND, OREGON

NE 1/4 SW 1/4 Sec. 34 T. 1 N. S. R. 1 E. W., W.M.

Bearing and distance from section or subdivision corner

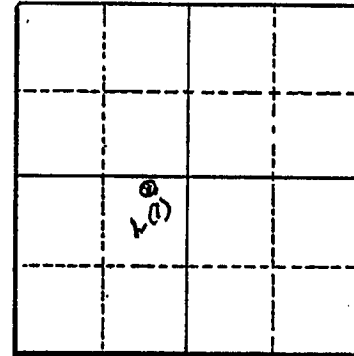

Altitude at well 310

Section 34

TYPE OF WELL: drilled Date Constructed 1935

Depth drilled 200' Depth cased - 200'

CASING RECORD: 6 inch

FINISH:

AQUIFERS: Basalt.

WATER LEVEL: 140 ft. -

PUMPING EQUIPMENT: Type turbine - PEERLESS H.P. 15
Capacity 120 G.P.M.

WELL TESTS:
Drawdown ft. after hours G.P.M.
Drawdown ft. after hours G.P.M.

USE OF WATER Domestic Temp. °F. 19

SOURCE OF INFORMATION USGS

DRILLER or DIGGER STRASSER DRILLING CO.

ADDITIONAL DATA:
Log Water Level Measurements Chemical Analysis Aquifer Test

REMARKS: Drawdown 160 ft. pumping 175 gpm for 36 hours.

STATE ENGINEER
Salem, Oregon

WASH
4950

Well Record

pg 2 of 2

STATE WELL NO. 1N/1W-34A
COUNTY Washington
APPLICATION NO. GR-949

OWNER: Alfred B Teufel


MAILING ADDRESS: 11414 NW Cornell Rd NW

LOCATION OF WELL: Owner's No. _____

CITY AND STATE: Portland

NE 1/4 NE 1/4 Sec. 34 T. 1 N. 3, R. 1 E. W.M.

Bearing and distance from section or subdivision corner 600' W & 200' S of NE Cor Sec 34

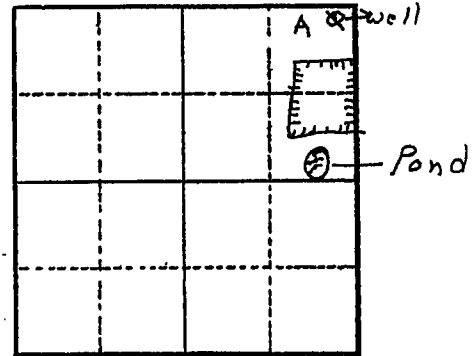

Altitude at well 460

TYPE OF WELL: drilled Date Constructed 1935

Depth drilled 200 Depth cased 200

Section 34

CASING RECORD:

6" Steel 0' - 200

FINISH:

AQUIFERS:

WATER LEVEL:

140'

PUMPING EQUIPMENT: Type Peerless Turbine H.P. 15 Elec
Capacity 100 G.P.M. at 100 lb Pressure Vertical

WELL TESTS: See Remarks
Drawdown _____ ft. after _____ hours _____ G.P.M.
Drawdown _____ ft. after _____ hours _____ G.P.M.

USE OF WATER Irrigation Temp. _____ °F. _____ 19 _____

SOURCE OF INFORMATION Owner

DRILLER or DIGGER Strasser Drilling Co.

ADDITIONAL DATA:
Log NA Water Level Measurements _____ Chemical Analysis _____ Aquifer Test _____

REMARKS:

The water in this well only comes up 60' but cannot lower the static level with a 100 GPM pump & a 15 hp motor.