

STATE ENGINEER
Salem, Oregon

WASH
4955

Well Record

STATE WELL NO. 1N/1W-35F
COUNTY Washington
APPLICATION NO. G-1210

OWNER: Samuel Walter


MAILING ADDRESS: 1325 N. W. 97th

LOCATION OF WELL: Owner's No. _____

CITY AND STATE: Portland, Oregon

SE 1/4 NW 1/4 Sec. 35 T. 1 N. 1 S., R. 1 E., W.M.

Bearing and distance from section or subdivision corner 1,100' N. & 400' W. from center of Section 35

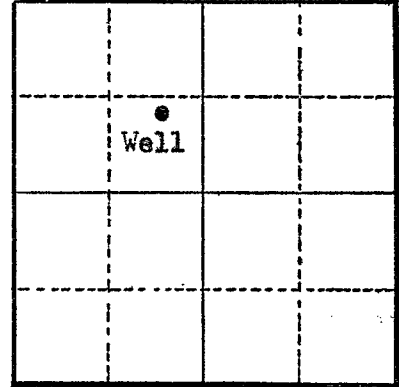

Section 35

Altitude at well 350 feet

TYPE OF WELL: Drilled Date Constructed 1946

Depth drilled 180 feet Depth cased 90 feet

CASING RECORD:

8 inch

FINISH:

AQUIFERS:

WATER LEVEL:

160 feet

PUMPING EQUIPMENT: Type Cook turbine H.P. 3

Capacity 30 G.P.M.

WELL TESTS:

Drawdown 20 ft. after _____ hours 28 G.P.M.

Drawdown _____ ft. after _____ hours _____ G.P.M.

USE OF WATER Domestic and irrigation Temp. _____ °F, 19 _____

SOURCE OF INFORMATION Related registration statement

DRILLER or DIGGER A. J. Grant

ADDITIONAL DATA:

Log _____ Water Level Measurements _____ Chemical Analysis _____ Aquifer Test _____

REMARKS:

Log: Clay 0 to 90 feet.
Rock 90 to 180 feet.

Irrigation of 3 acres.