

STATE ENGINEER  
Salem, Oregon

5115  
WASH

# Well Record

STATE WELL NO. N/24-3R  
COUNTY Washington  
APPLICATION NO. GR-164

OWNER: Ben J Nussbauer


MAILING ADDRESS: RT 1

LOCATION OF WELL: Owner's No. \_\_\_\_\_

CITY AND STATE: Hillsboro

SE 1/4 SE 1/4 Sec. 3 T. 1 N. S. R. 2 W., W.M.

Bearing and distance from section or subdivision corner N 14° 10' W 55-95' From SE Cor Sec 3.

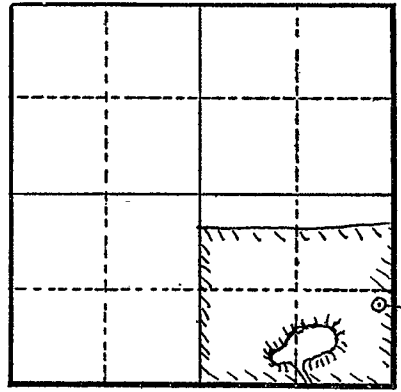

Altitude at well 220

TYPE OF WELL: Drilled Date Constructed May 1955

Depth drilled 532' Depth cased 165'

Section 3

CASING RECORD:  
8" 0' - 165'

FINISH:  
Per Forated w/ Acetylene Torch

AQUIFERS:

WATER LEVEL:  
90'

PUMPING EQUIPMENT: Type BJ-OBM 18 Stage Turbine H.P. 20 Elec.  
Capacity 120 G.P.M.

WELL TESTS:  
Drawdown 0' ft. after \_\_\_\_\_ hours 100 G.P.M.  
Drawdown \_\_\_\_\_ ft. after \_\_\_\_\_ hours \_\_\_\_\_ G.P.M.

USE OF WATER Irrigation Temp. \_\_\_\_\_ °F. \_\_\_\_\_, 19\_\_\_\_

SOURCE OF INFORMATION Owner

DRILLER or DIGGER Lance Strayer

ADDITIONAL DATA:  
Log \_\_\_\_\_ Water Level Measurements \_\_\_\_\_ Chemical Analysis \_\_\_\_\_ Aquifer Test \_\_\_\_\_

REMARKS:  
Log:  
Clay dirt - 0' - 160'  
Rock - 160 - 532'