

WASH  
5135

# Well Record

OWNER: E. Batchelder  
MAILING ADDRESS:

LOCATION OF WELL: Owner's No. CITY AND STATE:


1/4 1/4 Sec. T. N. S., R. E. W., W.M.

Bearing and distance from section or subdivision corner

Altitude at well 220

TYPE OF WELL: drilled Date Constructed

Depth drilled 547 Depth cased 345

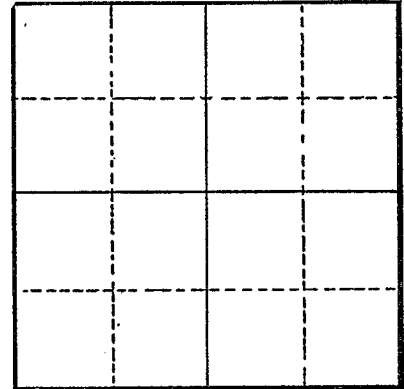

Section 5

CASING RECORD: 6 inch.

FINISH:

AQUIFERS: Basalt from 449 to 547 ft.

WATER LEVEL: 19 ft. below land surface.

PUMPING EQUIPMENT: Type turbine H.P.  
Capacity G.P.M.

WELL TESTS:  
Drawdown ft. after hours G.P.M.  
Drawdown ft. after hours G.P.M.

USE OF WATER irrigation Temp. °F., 19

SOURCE OF INFORMATION USGS

DRILLER or DIGGER

ADDITIONAL DATA:  
Log Water Level Measurements Chemical Analysis Aquifer Test

REMARKS: Basalt encountered at 342 ft; plans to irrigate 50 acres; pumped 300 gpm. with 86 ft. drawdown.