

STATE ENGINEER
Salem, Oregon

WASH
5158

Well Record

STATE WELL NO. 1N/2W - 6M
COUNTY WASHINGTON
APPLICATION NO. GR-2015

OWNER: John A. Van Domelen


MAILING ADDRESS: Rt. 3, Box 515

LOCATION OF WELL: Owner's No.

CITY AND STATE: Hillsboro, Oregon

NW 1/4 SW 1/4 Sec. 6 T. 1 N. S, R. 2 W., W.M.

Bearing and distance from section or subdivision corner N. 1350' E. 1050'

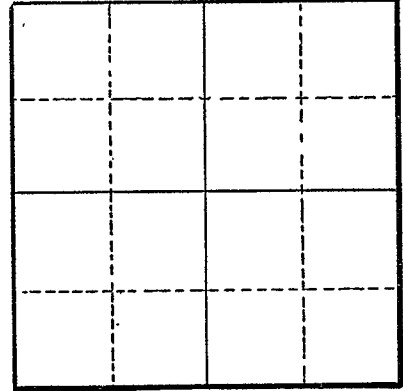

Section

Altitude at well

TYPE OF WELL: Drilled Date Constructed 1942

Depth drilled 453 Depth cased 327

CASING RECORD:

6-inch

FINISH:

AQUIFERS:

Clay and rock

WATER LEVEL:

80-feet

PUMPING EQUIPMENT: Type Myers Turbine H.P. 1
Capacity 20 G.P.M.

WELL TESTS:

Drawdown 0 ft. after hours Pumping 5 G.P.M.
Drawdown 60 ft. after hours Pumping 125 G.P.M.

USE OF WATER Irrigation Temp. °F., 19

SOURCE OF INFORMATION GR-1943

DRILLER or DIGGER A. J. Gaunt, Aloha, Oregon

ADDITIONAL DATA:

Log X Water Level Measurements Chemical Analysis Aquifer Test

REMARKS:

Clay 161 161
Rock 166 327