

STATE ENGINEER  
Salem, Oregon

WASH  
5346

# Well Record


STATE WELL NO. 1N/2W-15  
COUNTY Washington  
APPLICATION NO. GR-3492

OWNER: Gerald L. Diehl and Thais P. Diehl MAILING ADDRESS: Hillsboro

LOCATION OF WELL: Owner's No. CITY AND STATE: Oregon

NW 1/4 1/4 Sec. 15 T. 1 N. S, R. 2 E. W., W.M.

Bearing and distance from section or subdivision corner S 17° W. 62.60 chains from Ely NE Cor. of Chambers Claim

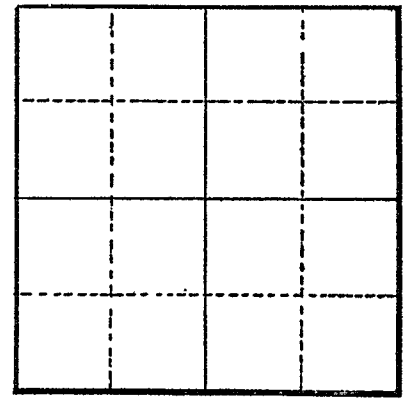

Section .....

Altitude at well .....

TYPE OF WELL: drilled Date Constructed 1953

Depth drilled 155' Depth cased 153'

### CASING RECORD:

6"

### FINISH:

### AQUIFERS:

topsoil, clay, sand

### WATER LEVEL:

15'

PUMPING EQUIPMENT: Type Jacuzzi injector H.P. 1 1/2  
Capacity 20 G.P.M.

### WELL TESTS:

Drawdown 65 ft. after ..... hours pumping 20 G.P.M.  
Drawdown ..... ft. after ..... hours ..... G.P.M.

USE OF WATER Irrigation Temp. °F. ...., 19

SOURCE OF INFORMATION GR-3222  
DRILLER or DIGGER A. M. Jamsen Drilling Co. Aloha, Oregon

### ADDITIONAL DATA:

Log  Water Level Measurements ..... Chemical Analysis ..... Aquifer Test .....

### REMARKS:

topsoil	10	10
blue clay	25	35
red clay	25	60
mixed red & gray clay	22	82
brown clay with sand layers	13	95
blue clay	55	150
blue sand-watering bearing	5	155