

WASH  
5351

# Well Record

OWNER: West Union School MAILING ADDRESS: \_\_\_\_\_

LOCATION OF WELL: Owner's No. \_\_\_\_\_ CITY AND STATE: \_\_\_\_\_


..... ¼ ..... ¼ Sec. ..... T. ..... N. E. S, R. ..... W., W.M.

Bearing and distance from section or subdivision corner \_\_\_\_\_

Altitude at well 210

TYPE OF WELL: drilled Date Constructed \_\_\_\_\_

Depth drilled 560 Depth cased 330

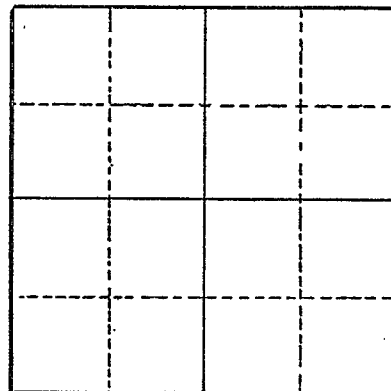

Section 15

CASING RECORD: 6 inch.

FINISH: \_\_\_\_\_

AQUIFERS: Basalt from 330 to 560 feet.

WATER LEVEL: 35 feet below land surface.

PUMPING EQUIPMENT: Type piston H.P. \_\_\_\_\_  
Capacity \_\_\_\_\_ G.P.M.

WELL TESTS:  
Drawdown \_\_\_\_\_ ft. after \_\_\_\_\_ hours \_\_\_\_\_ G.P.M.  
Drawdown \_\_\_\_\_ ft. after \_\_\_\_\_ hours \_\_\_\_\_ G.P.M.

USE OF WATER Public School Temp. \_\_\_\_\_ °F. \_\_\_\_\_, 19\_\_\_\_\_

SOURCE OF INFORMATION USGS

DRILLER or DIGGER \_\_\_\_\_

ADDITIONAL DATA:

Log  Water Level Measurements \_\_\_\_\_ Chemical Analysis \_\_\_\_\_ Aquifer Test \_\_\_\_\_

REMARKS: Pumps large amounts of fine red silt; see table 2 for log.

