

STATE ENGINEER
Salem, Oregon

WASH
5359

Well Record

STATE WELL NO. 1N/2W - 16E
COUNTY WASHINGTON
APPLICATION NO. GR-2008

OWNER: Richard L. Rice


MAILING ADDRESS: Rt. 3, Box 245

LOCATION OF WELL: Owner's No. _____

CITY AND STATE: Hillsboro, Oregon

SW 1/4 NW 1/4 Sec. 16 T. 1 N. 1/2 S. R. 2 E. 1/2 W., W.M.

Bearing and distance from section or subdivision corner S. 1370' E. 425'

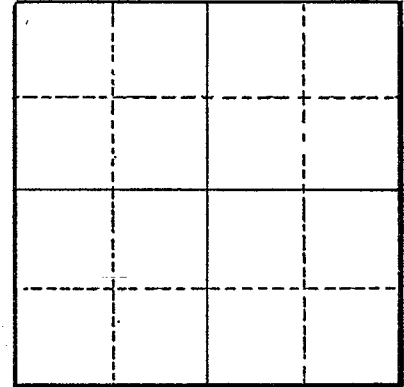

Section _____

Altitude at well _____

TYPE OF WELL: Drilled Date Constructed 1951

Depth drilled 180 Depth cased 180

CASING RECORD:

6-inch

FINISH:

AQUIFERS:

Clay

WATER LEVEL:

28' dropped to 58' in August 1957.

PUMPING EQUIPMENT: Type Berkley Jet H.P. 2
Capacity 30 G.P.M.

WELL TESTS:

Drawdown 32 ft. after _____ hours Pumping 30 G.P.M.
Drawdown _____ ft. after _____ hours _____ G.P.M.

USE OF WATER Irrigation Temp. _____ °F. _____, 19_____

SOURCE OF INFORMATION GR-1936

DRILLER or DIGGER M. G. Welch, 2115 N. W. 272, Hillsboro, Oregon

ADDITIONAL DATA:

Log X Water Level Measurements _____ Chemical Analysis _____ Aquifer Test _____

REMARKS:

Clay 90
Water layer in clay 2
Clay 88