

STATE ENGINEER
Salem, Oregon

WASH
5406

Well Record

STATE WELL NO. 1N/2W-20N
COUNTY Washington
APPLICATION NO. GR-1315

GR- 1271

OWNER: Hugh W. Farnham

MAILING
ADDRESS:

Rt. 1, Box 44


LOCATION OF WELL: Owner's No. #1

CITY AND
STATE:

Hillsboro, Oregon

SW $\frac{1}{4}$ SW $\frac{1}{4}$ Sec. 20 T. 1 N. S., R. 2 W., W.M.

Bearing and distance from section or subdivision
corner N.17°30'E. 750' from SW cor. Sec. 20.

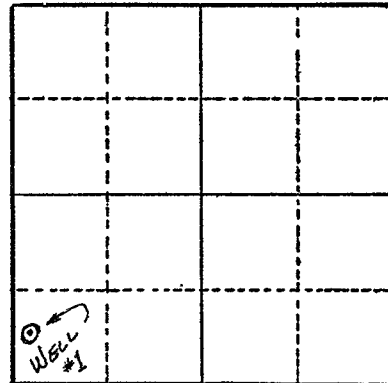

Section 20

Altitude at well 185 ft.

TYPE OF WELL: Drilled Date Constructed 1951

Depth drilled 45 ft. Depth cased 41 ft.

CASING RECORD:

8 inch

FINISH:

AQUIFERS:

WATER LEVEL:

10 ft.

PUMPING EQUIPMENT: Type Rotor pump H.P. 1½

Capacity 31 G.P.M.

WELL TESTS:

Drawdown 10 ft. after 31 hours G.P.M.

Drawdown _____ ft. after _____ hours G.P.M.

USE OF WATER Irrigation & Stock Temp. _____ °F., 19

SOURCE OF INFORMATION G. R. Record

DRILLER or DIGGER M. Welch

ADDITIONAL DATA:

Log _____ Water Level Measurements _____ Chemical Analysis _____ Aquifer Test _____

REMARKS:

Log:	Amity loam	0 to 2 ft.
	Brown clay	2 to 6 ft.
	Brown sand	6 to 21 ft.
	Blue clay	21 to 22½ ft.
	Brown & blue sand	22½ to 32½ ft.
	Blue clay - gumbo	32½ to 35 ft.
	Blue water sand	35 to 45 ft.

Irrigation of 15.3 acres.