

STATE ENGINEER
Salem, Oregon

WASH
5468

Well Record

STATE WELL NO. 1N/2W-20R0
COUNTY Washington
APPLICATION NO. GR-727

OWNER: Ebba N. Carothers


MAILING ADDRESS: 25755 SW Tualatin Valley Hwy

LOCATION OF WELL: Owner's No. _____

CITY AND STATE: Hillsboro, Oregon

SW 1/4 SE 1/4 Sec. 20 T. 1 N., R. 2 W., W.M.

Bearing and distance from section or subdivision corner 500' E. & 450' S. of NW corner of section 20.

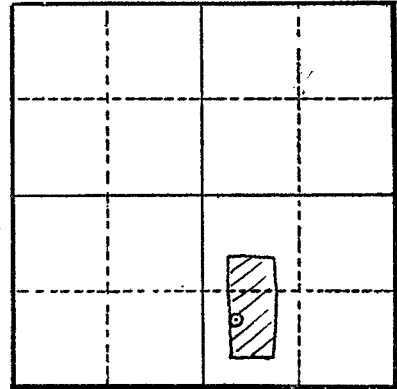

Section 20

Altitude at well 100 ft.

TYPE OF WELL: Drilled Date Constructed 5/52

Depth drilled 45' Depth cased 45'

CASING RECORD:

12 in. from 0' to 45'

FINISH:

AQUIFERS:

WATER LEVEL:

6 ft.

PUMPING EQUIPMENT: Type Single Phase elect. - Peerless turbine H.P. 5
Capacity 100 G.P.M.

WELL TESTS:
Drawdown 30 ft. after _____ hours 90 G.P.M.
Drawdown _____ ft. after _____ hours _____ G.P.M.

USE OF WATER Irrigation Temp. _____ °F., 19 _____

SOURCE OF INFORMATION GR-727

DRILLER or DIGGER Lee Barton, Hillsboro

ADDITIONAL DATA:

Log Water Level Measurements _____ Chemical Analysis _____ Aquifer Test _____

REMARKS:

