

STATE ENGINEER  
Salem, Oregon

WASH  
5514

# Well Record

STATE WELL NO. 1N/2W-21L(1)  
COUNTY Washington  
APPLICATION NO. GR-760

OWNER: Scotty LeFore


MAILING ADDRESS: Rt. 1, Box 234

LOCATION OF WELL: Owner's No. #1

CITY AND STATE: Hillsboro, Oregon

NE 1/4 SW 1/4 Sec. 21 T. 1 N. 2 W., W.M.

Bearing and distance from section or subdivision corner 2400' E. & 550' N. of NW corner of lot #40 of James H. Sewell acreage.

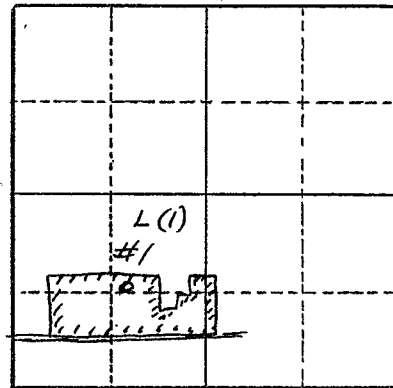

Section 21

Altitude at well 19.7 feet Interpolated

TYPE OF WELL: Drilled Date Constructed 1946

Depth drilled 50' Depth cased 50'

### CASING RECORD:

8 inch.

### FINISH:

### AQUIFERS:

WATER LEVEL: 35 ft.

PUMPING EQUIPMENT: Type Single Ph. Elect. - Berkeley Jet H.P. 2  
Capacity 50 G.P.M.

WELL TESTS:  
Drawdown 25 ft. after \_\_\_\_\_ hours 35 G.P.M.  
Drawdown \_\_\_\_\_ ft. after \_\_\_\_\_ hours \_\_\_\_\_ G.P.M.

USE OF WATER Irrigation Temp. \_\_\_\_\_ °F. \_\_\_\_\_, 19\_\_\_\_

SOURCE OF INFORMATION GR-760

DRILLER or DIGGER \_\_\_\_\_

### ADDITIONAL DATA:

Log Yes Water Level Measurements \_\_\_\_\_ Chemical Analysis \_\_\_\_\_ Aquifer Test \_\_\_\_\_

### REMARKS:

