

STATE ENGINEER
Salem, Oregon

WASH
5515

Well Record

STATE WELL NO. IN/2W-21L(2)
COUNTY Washington
APPLICATION NO. GR-761

OWNER: Scotty LeFore


MAILING ADDRESS: Rt. 1 Box 234

LOCATION OF WELL: Owner's No. # 2

CITY AND STATE: Hillsboro, Oregon

NE 1/4 SW 1/4 Sec. 21 T. 1 N. 2 W., W.M.

Bearing and distance from section or subdivision corner 2720' E. & 550' N. of NW corner of lot #40 of James H. Sewell acreage

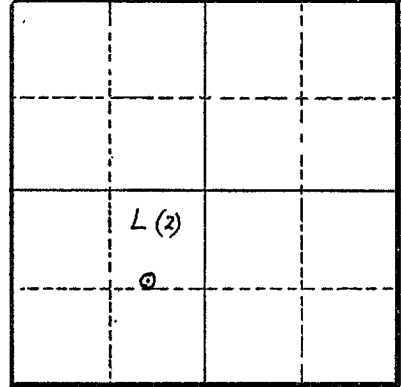

Section 21

Altitude at well 198 feet Interpolated

TYPE OF WELL: Drilled Date Constructed 1946

Depth drilled 50 ft. Depth cased 50 ft.

CASING RECORD:
8 inch

FINISH:

AQUIFERS:

WATER LEVEL: 35 feet

PUMPING EQUIPMENT: Type Single Ph. Elect. - Berkeley Jet H.P. 2
Capacity 50 G.P.M.

WELL TESTS:
Drawdown 25 ft. after _____ hours 35 G.P.M.
Drawdown _____ ft. after _____ hours _____ G.P.M.

USE OF WATER Irrigation Temp. _____ °F. _____, 19____
SOURCE OF INFORMATION GR-761

DRILLER or DIGGER _____
ADDITIONAL DATA:
Log Yes Water Level Measurements _____ Chemical Analysis _____ Aquifer Test _____

REMARKS:

