

STATE ENGINEER
Salem, Oregon

WASH
5529

Well Record

STATE WELL NO. IN/ZW - 22C
COUNTY WASHINGTON
APPLICATION NO. GR-1971

OWNER: Arnold Berger


MAILING ADDRESS: Rt. 1, Box 390

LOCATION OF WELL: Owner's No. #1

CITY AND STATE: Hillsboro, Oregon

NE 1/4 NW 1/4 Sec. 22 T. 1 N. S. R. 2 E. W., W.M.

Bearing and distance from section or subdivision corner 1850' S. 65°00' E.

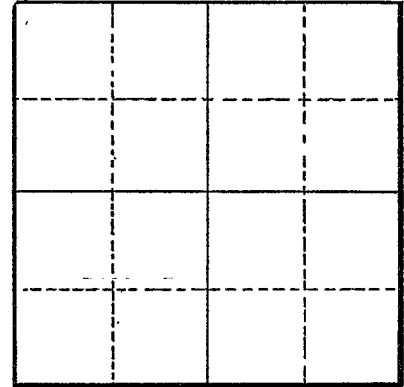

Altitude at well _____

TYPE OF WELL: Bored Date Constructed 1952

Depth drilled 100 Depth cased 100

Section _____

CASING RECORD:

12-inch

FINISH:

None

AQUIFERS:

Clay

WATER LEVEL:

20-feet

PUMPING EQUIPMENT: Type Berkley Jet H.P. 5
Capacity 60 G.P.M.

WELL TESTS:

Drawdown 60 ft. after _____ hours Pumping 35 G.P.M.
Drawdown 85 ft. after _____ hours Pumping 25 G.P.M.

USE OF WATER Irrigation Temp. _____ °F., 19 _____

SOURCE OF INFORMATION GR-1899

DRILLER or DIGGER Lee Barton, Rt. 1, Hillsboro, Oregon

ADDITIONAL DATA:

Log Water Level Measurements _____ Chemical Analysis _____ Aquifer Test _____

REMARKS:

