

STATE ENGINEER
Salem, Oregon

WASH
5000

Well Record

STATE WELL NO. 1N/2W-28D(1)
COUNTY Washington
APPLICATION NO. GR-791

OWNER: L. M. Waters


MAILING ADDRESS: Rt. 1 Box 238

LOCATION OF WELL: Owner's No. #1

CITY AND STATE: Hillsboro, Ore.

NW 1/4 NW 1/4 Sec. 28 T. 1 N. S. R. 2 W., W.M.

Bearing and distance from section or subdivision corner 341' S & 116' E. of NW corner of Section 28. being within lot #28 Sewell acreage

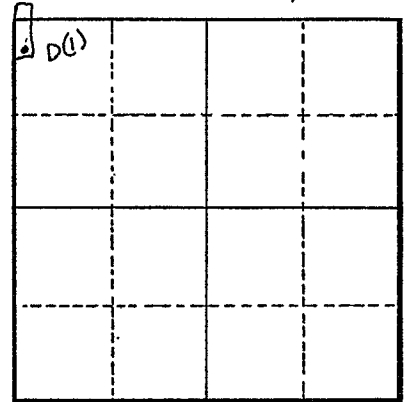

Altitude at well 202 ft.

TYPE OF WELL: Drilled Date Constructed Jan. 2, '52

Depth drilled 50' Depth cased 50'

Section 28

CASING RECORD:

12 inch.

FINISH:

Screen 45 ft.

AQUIFERS:

WATER LEVEL:

16 feet

PUMPING EQUIPMENT: Type Berkeley H.P. 2
Capacity 30 G.P.M.

WELL TESTS:

Drawdown	<u>35</u>	ft. after	hours	<u>30</u>	G.P.M.
Drawdown	<u>—</u>	ft. after	hours	<u>15</u>	G.P.M.

USE OF WATER Irrigation Temp. °F., 19.....

SOURCE OF INFORMATION GR-791

DRILLER or DIGGER L. M. Waters, Hillsboro

ADDITIONAL DATA:

Log Below Water Level Measurements Chemical Analysis Aquifer Test

REMARKS:

Blue clay & blue sand