

STATE ENGINEER
Salem, Oregon

WASH
5618

Well Record

STATE WELL NO. 1N2W-2900
COUNTY Washington
APPLICATION NO. CR-506

OWNER: Wayne Peirce


MAILING ADDRESS: 1900 N.W. 272nd Ave.

LOCATION OF WELL: Owner's No.

CITY AND STATE: Hillsboro, Ore

SW^{1/4} SE^{1/4} Sec. 29 T. 1^{N.}, R. 2^{E.} W., W.M.

Bearing and distance from section or subdivision corner From S.E. cor. John S. Griffin D.L.C. a distance of 1650 ft. S. 17°15' E.

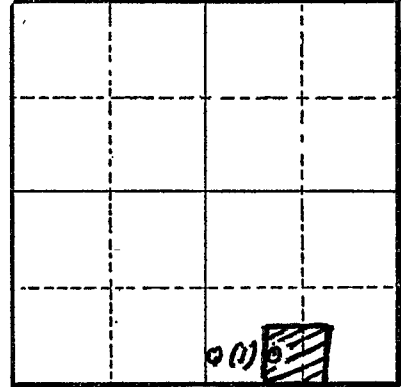

Section 29

Altitude at well 197

TYPE OF WELL: Auger drilled Date Constructed Sept. '47

Depth drilled 50 Depth cased 50

CASING RECORD:

6 inch

FINISH:

AQUIFERS:

WATER LEVEL:

12 Ft.

PUMPING EQUIPMENT: Type Wist Centrifugal H.P. 1/2
Capacity 70 G.P.M.

WELL TESTS:

Drawdown 2.7 ft. after hours 60 G.P.M.
Drawdown ft. after hours G.P.M.

USE OF WATER irrigation - 10 Ac. Temp. °F., 19.....

SOURCE OF INFORMATION CR-506

DRILLER or DIGGER

ADDITIONAL DATA:

Log X Water Level Measurements Chemical Analysis Aquifer Test

REMARKS:

