

STATE ENGINEER  
Salem, Oregon

WASH  
5664

# Well Record

STATE WELL NO. 1N/2W-30 K(1)  
COUNTY Washington  
APPLICATION NO. GR-258

OWNER: C.W. & Luella Wright


MAILING ADDRESS: Rt 1, Box 25

LOCATION OF WELL: Owner's No. #1

CITY AND STATE: Hillsboro, Oregon

NW 1/4 SE 1/4 Sec. 30 T. 1 N. 2 W., W.M.

Bearing and distance from section or subdivision corner 250 ft. south and 225 ft. east from center of section 30.

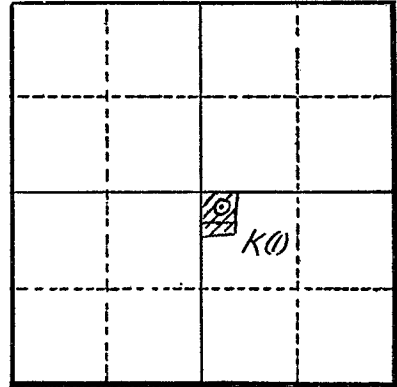

Section 30

Altitude at well 180 feet Interpolated

TYPE OF WELL: Drilled Date Constructed 5-27-53

Depth drilled 40 Depth cased unknown

### CASING RECORD:

unknown

### FINISH:

unknown

### AQUIFERS:

unknown

### WATER LEVEL:

20 feet below land surface

PUMPING EQUIPMENT: Type Berkeley Jet H.P. 2  
Capacity 40 G.P.M.

### WELL TESTS:

Drawdown ? ft. after ? hours ? G.P.M.  
Drawdown ? ft. after ? hours ? G.P.M.

USE OF WATER Irrigation 7.08 acres Temp. ? °F., 19.

SOURCE OF INFORMATION Req. Statement GR-258

DRILLER or DIGGER

### ADDITIONAL DATA:

Log no Water Level Measurements ? Chemical Analysis ? Aquifer Test ?

### REMARKS: