

STATE ENGINEER
Salem, Oregon


WASH Well Record
5665

STATE WELL NO. W2W-30 P0
COUNTY Washington
APPLICATION NO. GR-519

OWNER: Bernard Van MeHobete MAILING ADDRESS: 2015 N. W. Jackson school Rd
CITY AND STATE: Hillsboro, Ore

LOCATION OF WELL: Owner's No. SE 1/4 SW 1/4 Sec. 30 T. 1 N. R. 2 W., W.M.

Bearing and distance from section or subdivision corner 200 Ft. N. & 225 Ft. W. from S. 1/4 cor. sec. 30

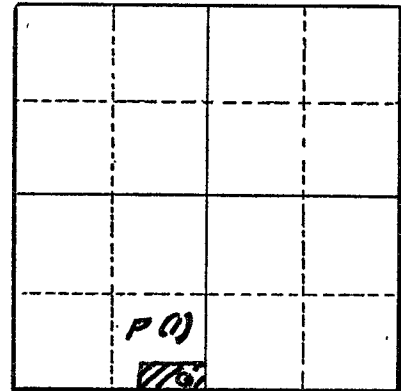

Section P(1)

Altitude at well 178

TYPE OF WELL: drilled Date Constructed April 51

Depth drilled 35 Depth cased 35

CASING RECORD:

8 inch

FINISH:

AQUIFERS:

WATER LEVEL:

10 ft.

PUMPING EQUIPMENT: Type Co-op Jet H.P. 2
Capacity 40 G.P.M.

WELL TESTS:

Drawdown 22 ft. after hours 35 G.P.M.
Drawdown ft. after hours G.P.M.

USE OF WATER irrigation - 6.5 Ac. Temp. °F. 19

SOURCE OF INFORMATION GR-519

DRILLER or DIGGER owner

ADDITIONAL DATA:

Log Water Level Measurements Chemical Analysis Aquifer Test

REMARKS:

↓
Soil --- 0' to 10'
Hardpan -- 10' to 12'
Remainder of well not logged.