

STATE ENGINEER
Salem, Oregon

WASH
5667

Well Record

STATE WELL NO. 1N / 2W - 30Q
COUNTY WASHINGTON
APPLICATION NO. GR-1974

OWNER: Ralph R. & Edna Younce


MAILING ADDRESS: 2170 N. W. Jackson School Rd.

LOCATION OF WELL: Owner's No. _____

CITY AND STATE: Hillsboro, Oregon

SW 1/4 SE 1/4 Sec. 30 T. 1 N. R. 2 E. W., W.M.

Bearing and distance from section or subdivision corner 2170' N/ 77° 0' W.

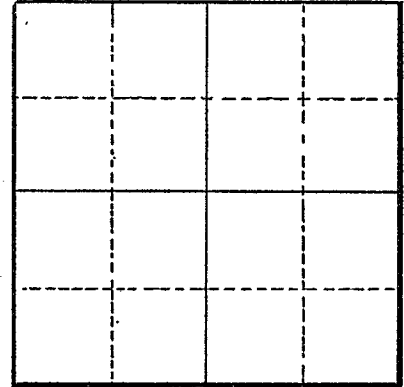

Section _____

Altitude at well _____

TYPE OF WELL: Drilled Date Constructed 1953

Depth drilled 26' Depth cased 24'

CASING RECORD:

8-inch

FINISH:

AQUIFERS:

WATER LEVEL:

15-feet

PUMPING EQUIPMENT: Type Berkley 1 1/2 Jet H.P. 1
Capacity 30 G.P.M.

WELL TESTS:
Drawdown 4 ft. after _____ hours Pumping 20 G.P.M.
Drawdown _____ ft. after _____ hours _____ G.P.M.

USE OF WATER Irrigation & Domestic Temp. _____ °F., 19 _____

SOURCE OF INFORMATION GR-1905

DRILLER or DIGGER Walter VanDyke N. W. Jackson School Rd., Hillsboro

ADDITIONAL DATA:

Log _____ Water Level Measurements _____ Chemical Analysis _____ Aquifer Test _____

REMARKS: