

STATE ENGINEER
Salem, Oregon

WASH
5735

Well Record

GR- 1246

STATE WELL NO. 1N/2W-31Q(2)
COUNTY Washington
APPLICATION NO. GR-1289

OWNER: Albert W. & Ethel E. Moore


MAILING ADDRESS: 673 E. Main St.

LOCATION OF WELL: Owner's No. #1

CITY AND STATE: Hillsboro, Oregon

SW 1/4 SE 1/4 Sec. 31 T. 1 N. R. 2 E. W., W.M.

Bearing and distance from section or subdivision
corner 121' N. & 41' W. from SE cor. of Lot 8 of
Blk. 2 of Ennes Addition to Hillsboro.

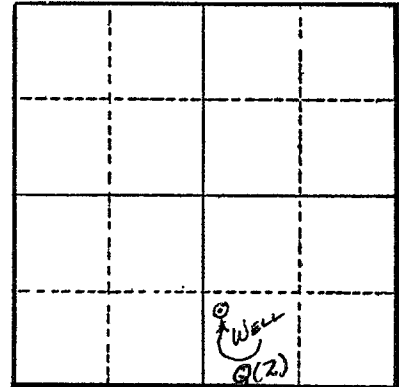

Section 31

Altitude at well 200 ft.

TYPE OF WELL: Drilled Date Constructed 1934

Depth drilled 26 ft. Depth cased 26 ft.

CASING RECORD:
6 inch

FINISH:

AQUIFERS:
Quicksand

WATER LEVEL:
14 ft.

PUMPING EQUIPMENT: Type Red Jacket Jet H.P. 1
Capacity 20 G.P.M.

WELL TESTS:
Drawdown 8 ft. after 20 hours G.P.M.
Drawdown ft. after hours G.P.M.

USE OF WATER Irrigation Temp. °F. 19

SOURCE OF INFORMATION G. R. Record

DRILLER or DIGGER Taylor

ADDITIONAL DATA:

Log Water Level Measurements Chemical Analysis Aquifer Test

REMARKS:

Log: Surface soil 0 to 15 ft.
Quicksand 15 to 19 ft.
Clay 19 to 26 ft.

Irrigation of 0.75 acres.