

STATE ENGINEER
Salem, Oregon

WASH
5774

Well Record

STATE WELL NO. 1N/2W-33M(2)
COUNTY Washington
APPLICATION NO. GR-1337

GR- 1293

OWNER: Reece N. Hathhorn


MAILING ADDRESS: 26445 NW Brogden

LOCATION OF WELL: Owner's No. #1

CITY AND STATE: Hillsboro, Oregon

NW 1/4 SW 1/4 Sec. 33 T. 1 N. R. 2 W., W.M.

Bearing and distance from section or subdivision corner 2180' N. & 370' E. from SW cor. Sec. 33.

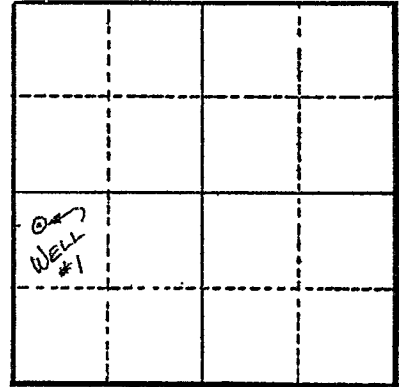

Section 33

Altitude at well 188 ft.

TYPE OF WELL: Drilled Date Constructed 1953

Depth drilled 40 ft. Depth cased 40 ft.

CASING RECORD:

6 in.

FINISH:

AQUIFERS:

WATER LEVEL:

35 ft.

PUMPING EQUIPMENT: Type Peerless H.P. 1

Capacity 20 G.P.M.

WELL TESTS:

Drawdown 35 ft. after 20 hours G.P.M.

Drawdown 28 ft. after 30 hours G.P.M.

USE OF WATER Irrigation Temp. °F. 19

SOURCE OF INFORMATION G. R. Record

DRILLER or DIGGER Owner

ADDITIONAL DATA:

Log N.A. Water Level Measurements Chemical Analysis Aquifer Test

REMARKS:

Irrigation of 2.3 acres.