

STATE ENGINEER
Salem, Oregon

WASH
5849

Well Record


STATE WELL NO. 1N/2W-34E
COUNTY Washington
APPLICATION NO. GR-2693

OWNER: H. W. Ray
MAILING ADDRESS: Route 1, Box 312

LOCATION OF WELL: Owner's No. #1
CITY AND STATE: Hillsboro, Oregon

SE 1/4 NW 1/4 Sec. 34 T. 1 N. R. 2 W., W.M.

Bearing and distance from section or subdivision
corner S. 13° W. 1500 ft.

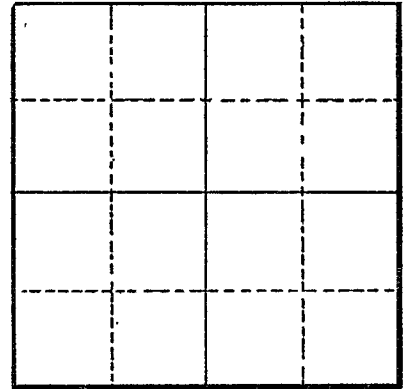

Section

Altitude at well

TYPE OF WELL: Dug Date Constructed 1936

Depth drilled 28' Depth cased 28'

CASING RECORD:

144 inch

FINISH:

AQUIFERS:

WATER LEVEL:

10 feet

PUMPING EQUIPMENT: Type Turbine H.P. 3
Capacity 30 G.P.M.

WELL TESTS:

Drawdown 18 ft. after hours pumping 30 G.P.M.
Drawdown ft. after hours G.P.M.

USE OF WATER irrigation Temp. °F. 19

SOURCE OF INFORMATION GR-2551

DRILLER or DIGGER

ADDITIONAL DATA:

Log Water Level Measurements Chemical Analysis Aquifer Test

REMARKS:

L-60407

For Official Use Only:

Received Date:

8-21-02

County Well Log ID #

Wash 5849

Well Identification Tag #

L-60407

WELL IDENTIFICATION APPLICATION FORM

(please see attached instructions)

BUYER/CURRENT LANDOWNER (FOR PROPERTY WELL IS LOCATED ON):

Name: Vallie E Cady

Mailing Address: 5611 NE Elam Young Pkwy

City: Hillsboro State: OR Zip: 97124 Phone: (503) 681-9802

NOTE: Well Identification Tag will be sent to the above address unless otherwise specified above.

DO NOT COMPLETE THIS FORM IF YOU ARE SHARING THE WELL ON ANOTHER'S PROPERTY.

WELL LOCATION:

County: Wash Well # (designation owner has given to well if multiple wells exist on same property):

Township: 1 North or South, Range: 2 East or West, Section: 34 NW 1/4 1/4

Tax Lot #: 800 (not the "tax acct.#") Type of Well: water supply Irrigation monitoring

Address of Well: 5611 NE Elam Young Pkwy, Hillsboro

Does this well have a formal water right associated with it? Yes: No: [checked]

(If unknown you may contact the Water Rights Information Group at 503-378-3739 extension 201 for research)

If Yes: Application #: Permit #: Certificate #:

(Optional): Latitude Longitude (May sometimes be obtained from Well Log Report)

WELL INFORMATION: (If available, attach copy of driller's well report. If report is not available please complete the following, at a minimum the prior landowner names going back until around the time the well would have been drilled. Prior landowners can be obtained from the County Assessor.)

Start Card #: Approx. Well Construction Date: 1935

Well Constructor: Unknown

Name of Land Owner at Time of Construction (or list of prior landowners) Harold W. Ray, then Archie Pitman, then Vallie E Cady

Well Depth (in feet): Approx 28 Ft Static Water Level (in feet): Unknown

Diameter of Exposed Well Casing (in inches): Hand dug (3 or 4 feet I think)

Please Return Completed Form to: Well ID Program @ Oregon Water Resources Department 158 12th Street NE - Salem, OR 97301-4172, or fax to 503-378-8130