

STATE ENGINEER  
Salem, Oregon

WASH  
5982

# Well Record

STATE WELL NO. 1N/3W-5G  
COUNTY WASHINGTON  
APPLICATION NO. GR-1770

OWNER: Joseph A. Duyck


MAILING ADDRESS: Rt. 1

LOCATION OF WELL: Owner's No.

CITY AND STATE: Banks, Oregon

SW 1/4 NE 1/4 Sec. 5 T. 1 N. R. 3 W., W.M.

Bearing and distance from section or subdivision corner 2150' S of NW corner of Section 5

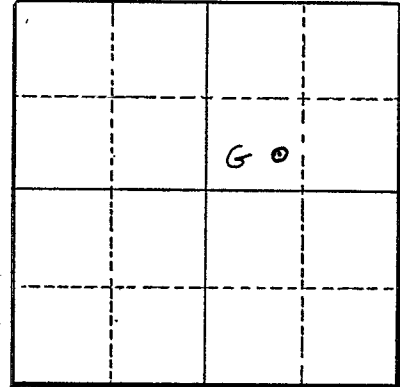

Section 5

Altitude at well

TYPE OF WELL: Drilled Date Constructed 1940

Depth drilled 605' Depth cased 440'

### CASING RECORD:

6-inch

### FINISH:

AQUIFERS: clay & sand  
solid rock

WATER LEVEL: 0'

PUMPING EQUIPMENT: Type Fairbanks Jet H.P. 1  
Capacity 20 G.P.M.

WELL TESTS:  
Drawdown 45 ft. after 25 hours G.P.M.  
Drawdown ft. after hours G.P.M.

USE OF WATER Irrigation Temp. °F., 19

SOURCE OF INFORMATION GR-3864  
DRILLER or DIGGER Beaverton Well Drilling Co.

ADDITIONAL DATA:  
Log  Water Level Measurements  Chemical Analysis  Aquifer Test

### REMARKS:

Clay & sand to 440'  
solid rock from 440 to 605'