

STATE ENGINEER
Salem, Oregon

Well Record

STATE WELL NO. 1N/3W-59
COUNTY WASHINGTON
APPLICATION NO. GR-2590

*WASH
5997*

OWNER: Julius J. Moore

MAILING ADDRESS: Rt. 1, Box 63


P 1072

LOCATION OF WELL: Owner's No. _____

CITY AND STATE: Cornelius, Oregon

SW 1/4 SE 1/4 Sec. 5 T. 1 N. 3 ~~S~~ R. 3 ~~W~~ W.M.

Bearing and distance from section or subdivision
corner 2460 N. N. W. from SE corner Section 5

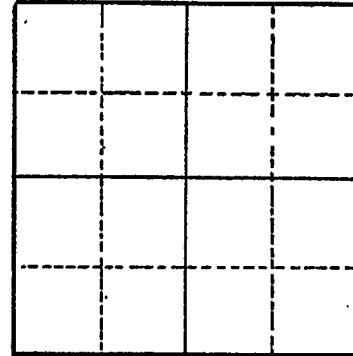

Section _____

Altitude at well _____

TYPE OF WELL: Drilled Date Constructed 1945

Depth drilled 523 Depth cased 513

CASING RECORD:

6-inch

FINISH:

AQUIFERS:

Blue clay, shale, rock, sand, wood, bark, limbs, sulphur & organic

WATER LEVEL:

PUMPING EQUIPMENT: Type Meyers Submersible H.P. 1 1/2
Capacity 1560 G.P.M.

WELL TESTS:

Drawdown 50 ft. after _____ hours Pumping 20 G.P.M.

Drawdown _____ ft. after _____ hours _____ G.P.M.

USE OF WATER Commercial Temp. _____ °F. _____, 19____

SOURCE OF INFORMATION GR-2457

DRILLER or DIGGER A. J. Gaunt, Aloha, Oregon

ADDITIONAL DATA:

Log Water Level Measurements _____ Chemical Analysis _____ Aquifer Test _____

REMARKS:

Blue clay to 492' Red Shale to 512' hard rock at 513 Heavy stream of water at 221' Sand and wood particles, bark & limbs Good flow artesian 330' Sand, sulphur and organic.

STATE ENGINEER
Salem, Oregon

WASH
5997

Well Record

STATE WELL NO. 1N/3W 50(1)
COUNTY Washington
APPLICATION NO. _____

OWNER: J. J. Moore

MAILING
ADDRESS: _____

Pg 2 of 2

LOCATION OF WELL: Owner's No. _____

CITY AND
STATE: _____

..... $\frac{1}{4}$ $\frac{1}{4}$ Sec. T. N. E.
S., R. W., W.M.

Bearing and distance from section or subdivision

corner _____

Altitude at well 175

TYPE OF WELL: drilled Date Constructed _____

Depth drilled 523 Depth cased 512

Section 5

CASING RECORD: 6 inch.

FINISH: _____

AQUIFERS: Basalt from 513 to 523 feet.

WATER LEVEL: F

PUMPING EQUIPMENT: Type 1st H.P. _____
Capacity _____ G.P.M.

WELL TESTS:

Drawdown _____ ft. after _____ hours _____ G.P.M.

Drawdown _____ ft. after _____ hours _____ G.P.M.

USE OF WATER domestic Temp. _____ °F. _____, 19

SOURCE OF INFORMATION USGS

DRILLER or DIGGER _____

ADDITIONAL DATA:

Log _____ Water Level Measurements _____ Chemical Analysis _____ Aquifer Test _____

REMARKS: Flowing about 3 to 5 gpm, water from 335 ft. sand has sulfur taste, a hardness of 20 ppm and chloride of 3 ppm.