

STATE ENGINEER
Salem, Oregon

WASH
6006

Well Record

STATE WELL NO. 1N/3W 5R(2)
COUNTY Washington
APPLICATION NO. _____

OWNER: do. MAILING ADDRESS: _____

LOCATION OF WELL: Owner's No. _____ CITY AND STATE: _____


_____ 1/4 _____ 1/4 Sec. _____ T. _____ N. _____ E. _____ S, R. _____ W., W.M.

Bearing and distance from section or subdivision corner _____

Altitude at well 180

TYPE OF WELL: drilled Date Constructed _____

Depth drilled 633 Depth cased 528

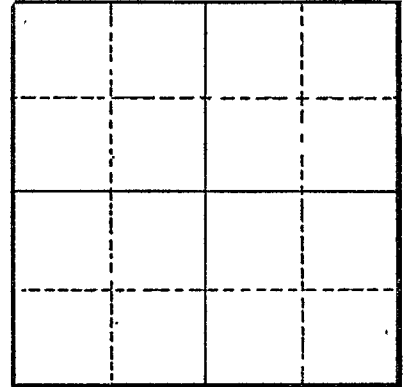

Section 5

CASING RECORD: 6 inch.

FINISH: _____

AQUIFERS: Basalt 528 to 633 ft.

WATER LEVEL: F

PUMPING EQUIPMENT: Type _____ H.P. _____
Capacity _____ G.P.M.

WELL TESTS:
Drawdown _____ ft. after _____ hours _____ G.P.M.
Drawdown _____ ft. after _____ hours _____ G.P.M.

USE OF WATER public supply Temp. _____ °F. _____, 19_____

SOURCE OF INFORMATION USGS

DRILLER or DIGGER _____

ADDITIONAL DATA:

Log _____ Water Level Measurements _____ Chemical Analysis _____ Aquifer Test _____

REMARKS: *