

STATE ENGINEER
Salem, Oregon

WASH
6075


Well Record

STATE WELL NO. W/3W - 8E
COUNTY WASHINGTON
APPLICATION NO. GR-2148

OWNER: A. W. Peters MAILING ADDRESS: Rt. 2, Box 249

LOCATION OF WELL: Owner's No. _____ CITY AND STATE: Forest Grove, Oregon

SW 1/4 NW 1/4 Sec. 8 T. 1 R. 3 W., W.M.
Bearing and distance from section or subdivision corner 2,630' S. 17° 0' E.

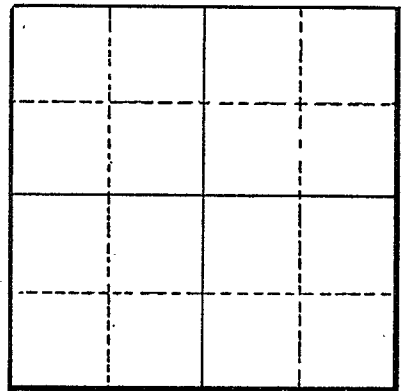

Section _____

Altitude at well _____

TYPE OF WELL: Drilled Date Constructed 1930
Depth drilled 965 Depth cased 945

CASING RECORD:

4-Inch

FINISH:

AQUIFERS:

Soil and rock

WATER LEVEL:

8-Feet

PUMPING EQUIPMENT: Type Jet H.P. 1
Capacity 20 G.P.M.

WELL TESTS:

Drawdown 30 ft. after _____ hours Pumping 17 G.P.M.
Drawdown _____ ft. after _____ hours _____ G.P.M.

USE OF WATER Irrigation Temp. _____ °F., 19

SOURCE OF INFORMATION GR-2060

DRILLER or DIGGER A. N. Janssen, Reedville, Oregon

ADDITIONAL DATA:

Log Water Level Measurements _____ Chemical Analysis _____ Aquifer Test _____

REMARKS:

Soil 0 930
Rock 930 965