

STATE ENGINEER
Salem, Oregon

WASH
6114

Well Record


STATE WELL NO. W-12B
COUNTY Washington
APPLICATION NO. CR-3571

OWNER: Ernest & Johanna Meyer MAILING ADDRESS: Route 3

LOCATION OF WELL: Owner's No. _____ CITY AND STATE: Hillsboro, Oregon

NW 1/4 NE 1/4 Sec. 12 T. 1 N. E, R. 3 W., W.M.

Bearing and distance from section or subdivision corner N. 72° 30' E. 2310' to NE corner Sec. 12

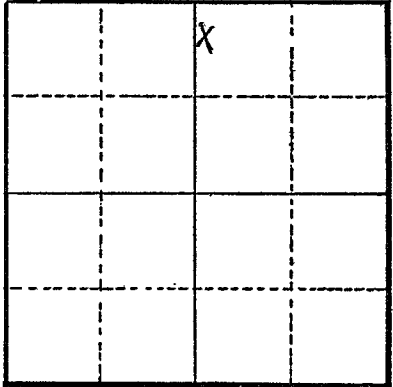

Section 12

Altitude at well _____

TYPE OF WELL: Drilled Date Constructed Sept., 1947

Depth drilled 145 ft. Depth cased 145 ft.

CASING RECORD:

6 inch standard well casing set to 145 feet

FINISH:

AQUIFERS:

WATER LEVEL:

12 feet below surface

PUMPING EQUIPMENT: Type Myers Jet 1" discharge electric H.P. 1

Capacity 48 G.P.M.

WELL TESTS:

Drawdown 38 ft. after _____ hours 10 G.P.M.

Drawdown _____ ft. after _____ hours _____ G.P.M.

USE OF WATER Irrigation Temp. _____ °F. _____, 19

SOURCE OF INFORMATION Well Registration Statement

DRILLER or DIGGER Jack Baron

ADDITIONAL DATA:

Log _____ Water Level Measurements _____ Chemical Analysis _____ Aquifer Test _____

REMARKS: