

STATE ENGINEER  
Salem, Oregon

WASH  
6140

# Well Record

GR- 1644

STATE WELL NO. 1N/3W-15C  
COUNTY Washington  
APPLICATION NO. GR- 1694

OWNER: Wilbert E. Salzwedel

MAILING  
ADDRESS:

Rt. 1, Box 80


LOCATION OF WELL: Owner's No. #1

CITY AND  
STATE:

Cornelius, Oregon

NE 1/4 NW 1/4 Sec. 15 T. 1 N. R. 3 W., W.M.

Bearing and distance from section or subdivision  
corner 900' S. 66° W. from N 1/4 cor. Sec. 15

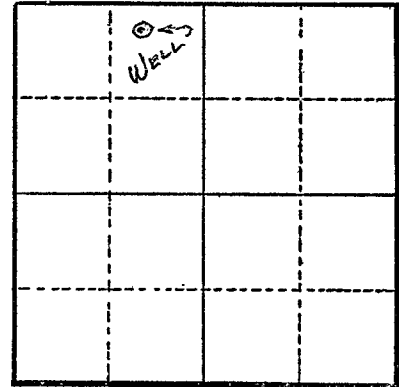

Section 15

Altitude at well

TYPE OF WELL: Drilled Date Constructed 1952

Depth drilled 81' Depth cased 81'

### CASING RECORD:

12" tile

### FINISH:

### AQUIFERS:

### WATER LEVEL:

18'

PUMPING EQUIPMENT: Type Coop jet H.P. 3  
Capacity 50 G.P.M.

### WELL TESTS:

Drawdown 20 ft. after 50 hours G.P.M.

Drawdown ft. after hours G.P.M.

USE OF WATER Irrigation Temp. °F. 19

SOURCE OF INFORMATION GR Record

DRILLER or DIGGER D. D. Perkins

### ADDITIONAL DATA:

Log N.A. Water Level Measurements Chemical Analysis Aquifer Test

### REMARKS:

Irrigation of 14.5 acres.