

STATE ENGINEER
Salem, Oregon

WASH
6/14/52

Well Record


STATE WELL NO. 1N/3W-15G
COUNTY Washington
APPLICATION NO. GR-4252

OWNER: Donald L. Cawrse MAILING ADDRESS: Route 1, Box 347

LOCATION OF WELL: Owner's No. CITY AND STATE: Cornelius, Oregon

SW 1/4 NE 1/4 Sec. 15 T. 1 N. X, R. 3 W., W.M.

Bearing and distance from section or subdivision corner S. 33° 0' W. 2740 ft. from NE Cor. Sec. 15

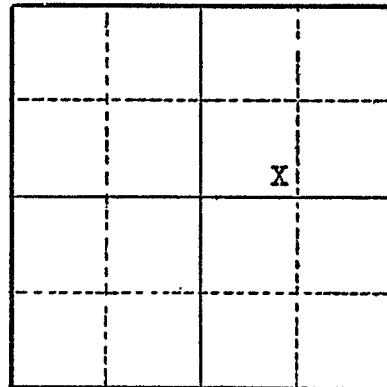

Section 15

Altitude at well

TYPE OF WELL: Drilled Date Constructed 5/51

Depth drilled 104 ft. Depth cased 104 ft.

CASING RECORD:

12 inch casing set to 104 feet

FINISH:

Perforated tile 3/8" hole from 0 to 104 feet

AQUIFERS:

WATER LEVEL:

30 feet below surface

PUMPING EQUIPMENT: Type Berkeley H.P. 5
Capacity 60 G.P.M.

WELL TESTS:

Drawdown 56 ft. after 60 hours 60 G.P.M.

Drawdown _____ ft. after _____ hours _____ G.P.M.

USE OF WATER Irrigation Temp. _____ °F. _____, 19_____

SOURCE OF INFORMATION Well Registration Statement Cert. # GR-3784

DRILLER or DIGGER _____

ADDITIONAL DATA:

Log X Water Level Measurements _____ Chemical Analysis _____ Aquifer Test _____

REMARKS:

Log:	Thickness	Depth to Bottom
Brown sand & clay	0	60
Blue clay	60	90
Green sand	90	104