

WASA
6145


Well Record

OWNER: Donald L. Cawrse MAILING ADDRESS: Route 1, Box 347

LOCATION OF WELL: Owner's No. _____ CITY AND STATE: Cornelius, Oregon

SE 1/4 NE 1/4 Sec. 15 T. 1 N. S, R. 3 W., W.M.

Bearing and distance from section or subdivision corner S. 25° 0' W. 2360 ft. from NE cor. Sec. 15

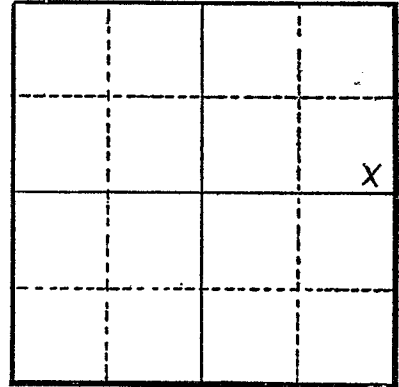

Section 15

Altitude at well _____

TYPE OF WELL: Drilled Date Constructed 5/1/51

Depth drilled 108 feet Depth cased 110 feet

CASING RECORD:

8" casing set to 110 feet

FINISH:

Perforations:
12" long - 2 rows on spiral - 1/4" wide from 0 to 110 feet

AQUIFERS:

WATER LEVEL:

PUMPING EQUIPMENT: Type Berkley jet H.P. 3
Capacity 30 G.P.M.

WELL TESTS:

Drawdown 60 ft. after _____ hours 30 G.P.M.
Drawdown _____ ft. after _____ hours _____ G.P.M.

USE OF WATER Irrigation Temp. _____ °F. _____, 19

SOURCE OF INFORMATION Well Registration Statement

DRILLER or DIGGER Lee Barton

ADDITIONAL DATA:

Log X Water Level Measurements _____ Chemical Analysis _____ Aquifer Test _____

REMARKS:

Log:	Thickness	Depth to Bottom
Brown clay and sand	0	30
Blue clay and sand	30	50
Very colored clay and sand	50	120