

STATE ENGINEER
Salem, Oregon

WASH
6/14/6

Well Record

STATE WELL NO. 1N/3W-15J
COUNTY Washington
APPLICATION NO. GR-1297

GR- 1254

OWNER: Albert L. & Florence J. Vanasche

MAILING

ADDRESS: Rt. 1, Box 350


LOCATION OF WELL: Owner's No.

CITY AND

STATE: Cornelius, Oregon

NE 1/4 SE 1/4 Sec. 15 T. 1 N. 3, R. 3 W., W.M.

Bearing and distance from section or subdivision
corner 1740' N37°W. from SE cor. Sec. 15

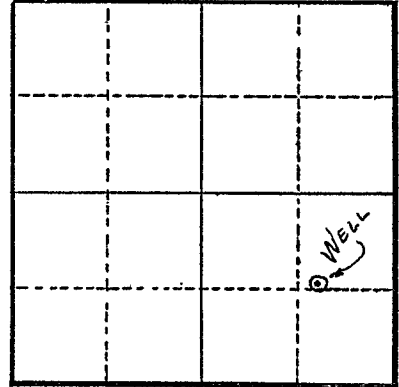

Section 15

Altitude at well

TYPE OF WELL: Bored Date Constructed 1952

Depth drilled 82 ft. Depth cased 82 ft.

CASING RECORD:

12 inch tile

FINISH:

AQUIFERS:

WATER LEVEL:

20 ft.

PUMPING EQUIPMENT: Type Berkeley jet H.P. 3

Capacity 60 G.P.M.

WELL TESTS:

Drawdown 75 ft. after 60 hours G.P.M.

Drawdown ft. after hours G.P.M.

USE OF WATER Irrigation Temp. °F., 19

SOURCE OF INFORMATION G. R. Record

DRILLER or DIGGER

ADDITIONAL DATA:

Log N.A. Water Level Measurements Chemical Analysis Aquifer Test

REMARKS:

Irrigation of 17.7 acres