

STATE ENGINEER
Salem, Oregon

WASH
01147

Well Record

STATE WELL NO. 1N/3W-15 L
COUNTY WASHINGTON
APPLICATION NO. GR-2799

OWNER: Lawrence Teate Taute


MAILING ADDRESS: Rt 1 Box 35

LOCATION OF WELL: Owner's No. _____

CITY AND STATE: Cornelius, Oregon

NE 1/4 SW 1/4 Sec. 15 T. 1 N. 3 R. 3 W., W.M.

Bearing and distance from section or subdivision corner 1420' E & 200' S from W 1/4 Cor Sec 15

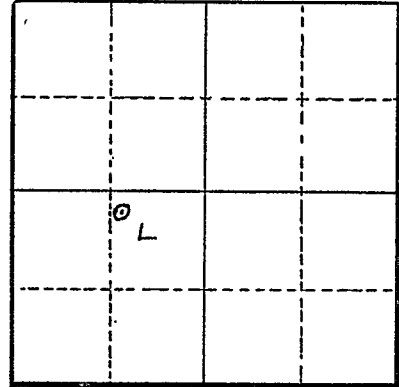

Section 15

Altitude at well _____

TYPE OF WELL: Drilled Date Constructed 1954

Depth drilled 45' Depth cased 42'

CASING RECORD:

6-inch

FINISH:

AQUIFERS:

Top soil & clay, Blue clay & sand

WATER LEVEL:

14'

PUMPING EQUIPMENT: Type Berkeley Centrifugal H.P. 1/2
Capacity 20 G.P.M.

WELL TESTS:

Drawdown 20 ft. after _____ hours 23 G.P.M.
Drawdown _____ ft. after _____ hours _____ G.P.M.

USE OF WATER Irrigation Temp. _____ °F., 19

SOURCE OF INFORMATION GR-3910

DRILLER or DIGGER _____

ADDITIONAL DATA:

Log ^x Water Level Measurements _____ Chemical Analysis _____ Aquifer Test _____

REMARKS:

Top soil & clay 19'
Blue clay & sand 23'