

WASH
 0162

WATER WELL REPORT
 STATE OF OREGON

5102
 State Well No. 1N/3W-16F1
 State Permit No. GR-3581

(1) OWNER:
 Name Merton Saknow
 Address _____

(2) LOCATION OF WELL:
 County WASH. Owner's number, if any—
 1/4 Section T. R. W.M.
 Bearing and distance from section or subdivision corner

(3) TYPE OF WORK (check):
 Well Deepening Reconditioning Abandon
 If abandonment, describe material and procedure in Item 11.

(4) PROPOSED USE (check):
 Domestic Industrial Municipal
 Test Well Other

(5) TYPE OF WELL:
 Rotary Driven
 Cable Jetted
 Dug Bored

(6) CASING INSTALLED:
 Threaded Welded
 5 1/2" Diam. from 0 ft. to 82 ft. Gage 7/32
 5 1/2" Diam. from 80 ft. to 110 3/4 ft. Gage 5/32
 " Diam. from _____ ft. to _____ ft. Gage _____

(7) PERFORATIONS:
 Perforated? Yes No
 Type of perforator used Torch
 SIZE of perforations 1/4 in. by 12 in.
 _____ perforations from 20 ft. to 82 ft.
 _____ perforations from _____ ft. to _____ ft.
LINEY _____ perforations from 5 1/2 OD ft. to 22 1/2 ft.
 _____ perforations from _____ ft. to _____ ft.

(8) SCREENS:
 Well screen installed Yes No
 Manufacturer's Name _____
 Model No. _____
 Diam. _____ Slot size _____ Set from _____ ft. to _____ ft.
 Diam. _____ Slot size _____ Set from _____ ft. to _____ ft.

(9) CONSTRUCTION:
 Well gravel packed? Yes No Size of gravel: 1/2 Peg
 Gravel placed from _____ ft. to _____ ft.
 Was a surface seal provided? Yes No To what depth? _____ ft.
 Material used in seal—
 Did any strata contain unusable water? Yes No Open hole
 Type of water? _____ Depth of strata 20-110
 Method of sealing strata off _____

(10) WATER LEVELS:
 Static level 4" ft. below land surface Date _____
 Artesian pressure _____ lbs. per square inch Date _____

Log Accepted by:
 [Signed] _____ Date _____, 19____
 (Owner)

(11) WELL TESTS:
 Drawdown is amount water level is lowered below static level
 Was a pump test made? Yes No If yes, by whom?
 Yield: 50 gal./min. with 25 ft. drawdown after _____ hrs.
 " " " " " "
 " " " " " "
 Bailor test gal./min. with _____ ft. drawdown after _____ hrs.
 Artesian flow g.p.m. Date _____
 Temperature of water _____ Was a chemical analysis made? Yes No

(12) WELL LOG:
 Diameter of well 20 inches.
 Depth drilled 110 ft. Depth of completed well 110 ft.
 Formation: Describe by color, character, size of material and structure, and show thickness of aquifers and the kind and nature of the material in each stratum penetrated, with at least one entry for each change of formation.

MATERIAL	FROM	TO
THIS Well is open		
20" hole layered sand and clay formation		
to 110 ft		
Brown to 20 ft		
Blue 97		
Brown sand	101	110
layers clay		
Brown clay		110

Work started _____ 19____ Completed _____ 19____

(13) PUMP:
 Manufacturer's Name _____
 Type: _____ H.P. _____

Well Driller's Statement:
 This well was drilled under my jurisdiction and this report is true to the best of my knowledge and belief.
 NAME LEF Barton WELL Drilling
 (Person, firm, or corporation) (Type or print)
 Address RT 1 Box 2, 33 Hillsbard Ore
 Driller's well number _____
 [Signed] _____ (Well Driller)
 License No. 28 Date 3-24, 1958

STATE ENGINEER
Salem, Oregon

Well Record

STATE WELL NO. 1N/3W-16B
COUNTY Washington
APPLICATION NO. GR-3581

*WASH
6162*

OWNER: Merton B. Sabrow

MAILING

ADDRESS: Route 1, Box 45


CITY AND

STATE: Cornelius, Oregon

LOCATION OF WELL: Owner's No.

SE 1/4 NW 1/4 Sec. 16 T. 1 N. E. R. 3 W., W.M.

Bearing and distance from section or subdivision
corner 1700' S 59° in from NE corner of Sec. 16

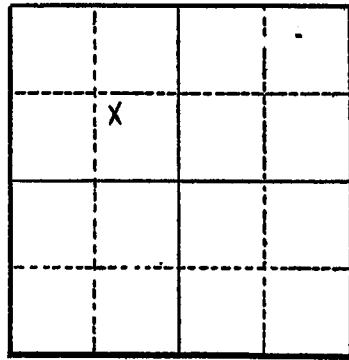

Section 16

Altitude at well

TYPE OF WELL: DRILLED Date Constructed 1952

Depth drilled 110 ft. Depth cased 110 ft.

CASING RECORD:

8 inch steel casing set from 0 ft. to 82 ft.
5 1/2 inch casing set from 82 ft. to 110 ft.

FINISH:

1/4" x 12" perforations from 20 ft. to 82 ft.

AQUIFERS:

WATER LEVEL:

PUMPING EQUIPMENT: Type Berkeley jet electric H.P. 5
Capacity 70 G.P.M.

WELL TESTS:

Drawdown 30 ft. after 70 hours G.P.M.
Drawdown ft. after hours G.P.M.

USE OF WATER Irrigation Temp. °F. 19

SOURCE OF INFORMATION Well Registration Statement

DRILLER or DIGGER Les Barton Well Drilling

ADDITIONAL DATA:

Log X Water Level Measurements Chemical Analysis Aquifer Test

REMARKS:

Log:	Thickness	Depth to Bottom
Brown soil and subsoil	20	20
Blue clay	77	97
Brown sand	4	101
Brown clay	9	110