



STATE ENGINEER  
Salem, Oregon

WASH  
6/16/4

# Well Record

STATE WELL NO. 1N/3W-16H  
COUNTY Wash ~~Washington~~  
APPLICATION NO. GR-3582

Pg 2 of 2

OWNER: Merton B. Sahnck

MAILING

ADDRESS: Route 1, Box 45

LOCATION OF WELL: Owner's No. \_\_\_\_\_


CITY AND

STATE: Cornelius, Oregon

SE ¼ NW ¼ Sec. 16 T. 1 N. E, R. 3 W., W.M.

Bearing and distance from section or subdivision

corner S. 40° 0' E. 1800 ft. from NE corner of  
Sec. 16

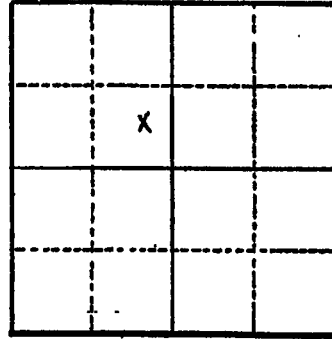

Section 16

Altitude at well \_\_\_\_\_

TYPE OF WELL: Drilled Date Constructed 9/50

Depth drilled 45 ft. Depth cased 45 ft.

### CASING RECORD:

8 inch tile casing set to 45 feet

### FINISH:

### AQUIFERS:

### WATER LEVEL:

10 feet below surface

PUMPING EQUIPMENT: Type Barkley jet electric H.P. 3

Capacity 36 G.P.M.

### WELL TESTS:

Drawdown 25 ft. after \_\_\_\_\_ hours 40 G.P.M.

Drawdown \_\_\_\_\_ ft. after \_\_\_\_\_ hours \_\_\_\_\_ G.P.M.

USE OF WATER Irrigation Temp. \_\_\_\_\_ °F., 19 \_\_\_\_\_

SOURCE OF INFORMATION Well Registration Statement

DRILLER or DIGGER Carl Miller

### ADDITIONAL DATA:

Log \_\_\_\_\_ Water Level Measurements \_\_\_\_\_ Chemical Analysis \_\_\_\_\_ Aquifer Test \_\_\_\_\_

### REMARKS: