

STATE ENGINEER
Salem, Oregon

WASH
6/16/5


Well Record

STATE WELL NO. 1N/3W-16H
COUNTY Washington
APPLICATION NO. CR 583

OWNER: Merton B. Sabnow
MAILING ADDRESS: Route 1, Box 45

LOCATION OF WELL: Owner's No. _____
CITY AND STATE: Cornelius, Oregon

SE 1/4 NE 1/4 Sec. 16 T. 1 N. R. 3 W., W.M.
Bearing and distance from section or subdivision
corner S. 25° 0' E., 1970 ft. from NE corner
Sec. 16

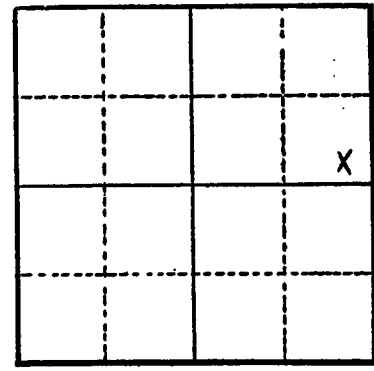

Section 16

Altitude at well _____

TYPE OF WELL: Drilled Date Constructed Aug., 1949

Depth drilled 68 ft. Depth cased 68 ft.

CASING RECORD:

12 inch tile casing set to 68 feet

FINISH:

AQUIFERS:

WATER LEVEL:

10 feet below surface

PUMPING EQUIPMENT: Type Berkeley jet electric H.P. 3
Capacity 50 G.P.M.

WELL TESTS:

Drawdown 30 ft. after _____ hours 50 G.P.M.
Drawdown _____ ft. after _____ hours _____ G.P.M.

USE OF WATER Irrigation Temp. °F. _____, 19.
SOURCE OF INFORMATION Well Registration Statement

DRILLER or DIGGER Lee Burton

ADDITIONAL DATA:

Log Water Level Measurements _____ Chemical Analysis _____ Aquifer Test _____

REMARKS:

Log:
Narrow clay and sand strata
from 0-68 feet

Reg. Cert.
3292

