

STATE ENGINEER  
Salem, Oregon

WASH  
6245

# Well Record

GR- 1679

STATE WELL NO. 1N/3W-22F  
COUNTY Washington  
APPLICATION NO. GR- 1730

OWNER: Jack Delplanche

MAILING

ADDRESS: Rt. 1, Box 355


LOCATION OF WELL: Owner's No.

CITY AND

STATE: Cornelius, Oregon

SE 1/4 NW 1/4 Sec. 22 T. 1 N. R. 3 W., W.M.

Bearing and distance from section or subdivision  
corner From NE cor. Sec. 22 - S62°W. 4125'

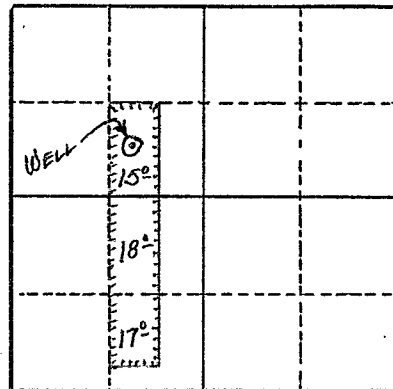

Section 22

Altitude at well 200'

TYPE OF WELL: Drilled Date Constructed 1952

Depth drilled 216' 8" Depth cased 216' 8"

### CASING RECORD:

12"

### FINISH:

### AQUIFERS:

### WATER LEVEL:

16'

PUMPING EQUIPMENT: Type Layne & Bowler 4" Turbine H.P. 15  
Capacity 200 G.P.M.

### WELL TESTS:

Drawdown 60 ft. after Sept. '52 hours 80 G.P.M.  
Drawdown 140 ft. after Oct. '52 hours 160 G.P.M.

USE OF WATER Irrigation Temp. °F. 19

SOURCE OF INFORMATION GR Record

DRILLER or DIGGER

### ADDITIONAL DATA:

Log  Water Level Measurements  Chemical Analysis  Aquifer Test

REMARKS: Log: Top soil 0 to 16 ft.  
Fine sand & water 16 to 63 ft.  
Sticky ~~XXXX~~ blue clay 63 to 88 ft.  
Blue sandy clay 88 to 136 ft.  
Blue sand & quartz grits - W.B. 136 to 147 ft.  
Blue clay 147 to 182 ft.  
Blue sandy clay - some water 182 to 191 ft.  
Blue & yellow clay 191 to 203 ft.  
Gravel, water also wood particles 203 to 208 ft.  
Blue & yellow clay 208 to 255 ft.

Irrigation of 50 acres.