

STATE ENGINEER  
Salem, Oregon

WASH  
6267

# Well Record


STATE WELL NO. 1N13W-23G  
COUNTY WASHINGTON  
APPLICATION NO. GR-2067

OWNER: Esther C. McDonald MAILING ADDRESS: Rt. 1 Box 250A

LOCATION OF WELL: Owner's No. \_\_\_\_\_ CITY AND STATE: Cornelius, Oregon

SW 1/4 NE 1/4 Sec. 23 T. 1 N. 8, R. 3 W., W.M.

Bearing and distance from section or subdivision corner 2510' 5.56° 0' W

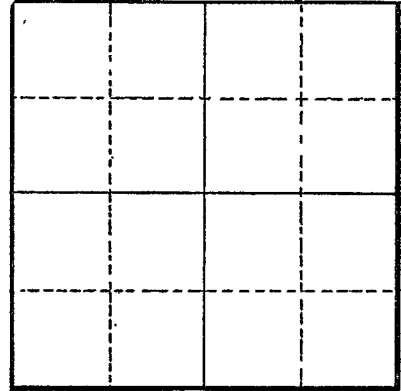

Section \_\_\_\_\_

Altitude at well \_\_\_\_\_

TYPE OF WELL: Drilled Date Constructed 1953

Depth drilled 284 Depth cased 120

### CASING RECORD:

6-Inch

### FINISH:

### AQUIFERS:

### WATER LEVEL:

120-feet

PUMPING EQUIPMENT: Type Saccuzi H.P. 1 1/2  
Capacity 7 G.P.M.

### WELL TESTS:

Drawdown 100 ft. after \_\_\_\_\_ hours Pumping 2 1/2 G.P.M.  
Drawdown \_\_\_\_\_ ft. after \_\_\_\_\_ hours \_\_\_\_\_ G.P.M.

USE OF WATER Irrigation Temp. \_\_\_\_\_ °F. \_\_\_\_\_, 19\_\_\_\_

SOURCE OF INFORMATION GR-1984

DRILLER or DIGGER Jack Barron, Beaverton, Oregon

### ADDITIONAL DATA:

Log \_\_\_\_\_ Water Level Measurements \_\_\_\_\_ Chemical Analysis \_\_\_\_\_ Aquifer Test \_\_\_\_\_

### REMARKS: