

STATE ENGINEER  
Salem, Oregon

WASH  
6281

# Well Record

STATE WELL NO. 1N/3W-24J70  
COUNTY Washington  
APPLICATION NO. GR-530

OWNER: George Zimmerman


MAILING ADDRESS: Rt 3, Box 202 Pg 1 of 2

LOCATION OF WELL: Owner's No. 1

CITY AND STATE: Hillsboro, Oregon

NE 1/4 SE 1/4 Sec. 24 T. 1 N. 3 W., W.M.

Bearing and distance from section or subdivision corner Approx. 3300 ft S. & 620 ft W. of N.E. cor. sec. 24

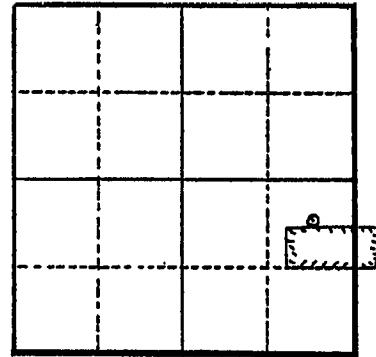

Altitude at well 175 feet Interpolated

TYPE OF WELL: Drilled Date Constructed \_\_\_\_\_

Depth drilled 60 ft. Depth cased \_\_\_\_\_

Section 24

CASING RECORD:  
6 inch

FINISH:

AQUIFERS:

WATER LEVEL:

25 ft.

PUMPING EQUIPMENT: Type Berkeley Jet H.P. 1 1/2  
Capacity 20 G.P.M.

WELL TESTS:

Drawdown 15 ft. after \_\_\_\_\_ hours \_\_\_\_\_ 20 G.P.M.

Drawdown \_\_\_\_\_ ft. after \_\_\_\_\_ hours \_\_\_\_\_ G.P.M.

USE OF WATER irrigation - 12 ac. Temp. \_\_\_\_\_ °F. \_\_\_\_\_, 19\_\_\_\_\_

SOURCE OF INFORMATION GR-530

DRILLER or DIGGER Art Gault; Aloha, Ore.

ADDITIONAL DATA:

Log X Water Level Measurements \_\_\_\_\_ Chemical Analysis \_\_\_\_\_ Aquifer Test \_\_\_\_\_

REMARKS:

