

STATE ENGINEER
Salem, Oregon

WASH
6291

Well Record

STATE WELL NO. W3W-25B(1)
COUNTY Wash.
APPLICATION NO. GR-582

OWNER: W. W. Bassett


MAILING ADDRESS: Rt. 3 Box 196A

LOCATION OF WELL: Owner's No. _____

CITY AND STATE: Hillsboro, Ore.

NW 1/4 NE 1/4 Sec. 25 T. 1 N., R. 3 W., W.M.

Bearing and distance from section or subdivision corner 260 ft. S. & 840 ft. E.
From N.W. 1/4 cor. sec. 25

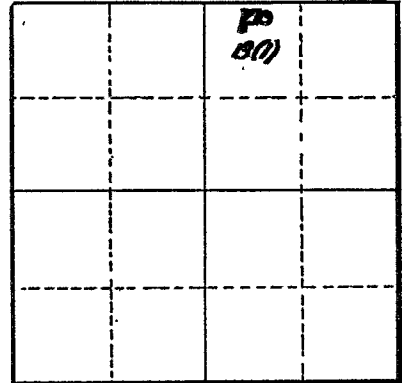

Section 25

Altitude at well 191

TYPE OF WELL: drilled Date Constructed May 50

Depth drilled 62 Depth cased 62

CASING RECORD:

6 inch

FINISH:

AQUIFERS:

WATER LEVEL:

22

PUMPING EQUIPMENT: Type Jacuzzi H.P. 2 1/2
Capacity 35 to 40 G.P.M.

WELL TESTS:

Drawdown 13 ft. after _____ hours _____ 35 G.P.M.
Drawdown _____ ft. after _____ hours _____ G.P.M.

USE OF WATER Domestic & Irrigation 3 Ac. Temp. _____ °F., 19_____
SOURCE OF INFORMATION GR-582

DRILLER or DIGGER _____

ADDITIONAL DATA:

Log ? Water Level Measurements _____ Chemical Analysis _____ Aquifer Test _____

REMARKS: