

STATE ENGINEER
Salem, Oregon

WASH
6293

Well Record


STATE WELL NO. 1W3W-2511
COUNTY Wash
APPLICATION NO. H.R. 2256

OWNER: H. P. Mc. Connell MAILING ADDRESS: Rt. 3, Box 189

LOCATION OF WELL: Owner's No. _____ CITY AND STATE: Hillsboro, Oregon

SE 1/4 NE 1/4 Sec. 25 T. 1 N. S. R. 3 E. W., W.M.

Bearing and distance from section or subdivision corner 2375' S. 16° 30' W.

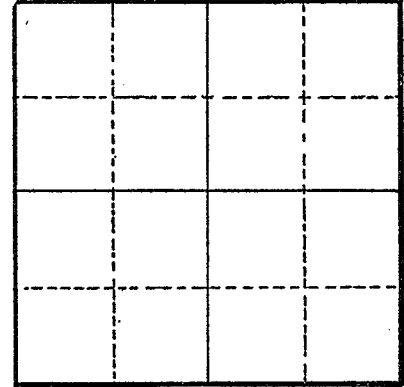

Section _____

Altitude at well _____

TYPE OF WELL: Bored Date Constructed 1954

Depth drilled 45 Depth cased 45

CASING RECORD:

12-Inch

FINISH:

1/4" perforations from 25' to 45'

AQUIFERS:

Clay, muck and Sand

WATER LEVEL:

16-feet

PUMPING EQUIPMENT: Type Universal Jet H.P. 2
Capacity 30 G.P.M.

WELL TESTS:

Drawdown 40 ft. after _____ hours Pumping 20 G.P.M.
Drawdown _____ ft. after _____ hours _____ G.P.M.

USE OF WATER Irrigation Temp. _____ °F. _____, 19____

SOURCE OF INFORMATION HR-2238

DRILLER or DIGGER Lee Barton & Self

ADDITIONAL DATA:

Log X Water Level Measurements _____ Chemical Analysis _____ Aquifer Test _____

REMARKS:

Clay - 15
Blue Muck & Sand After boring ~~30~~ 30