

STATE ENGINEER  
Salem, Oregon

WASH  
6343

# Well Record


STATE WELL NO. 1N/3W-27G  
COUNTY Washington  
APPLICATION NO. GR-4071

OWNER: Arnold F. Steinke  
MAILING ADDRESS: Route 3, Box 604

LOCATION OF WELL: Owner's No. \_\_\_\_\_  
CITY AND STATE: Hillsboro, Oregon

SW 1/4 NE 1/4 Sec. 27 T. 1 N. R. 3 W., W.M.

Bearing and distance from section or subdivision  
corner 3050' SW 1/4 of NE Cor. Sec. 27 on a bearing  
of 227°

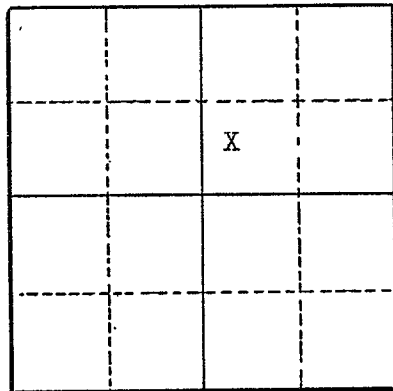

Section 27

Altitude at well \_\_\_\_\_

TYPE OF WELL: Drilled Date Constructed 1944

Depth drilled 101 ft. Depth cased 101 ft.

### CASING RECORD:

6 inch casing set to 101 feet

### FINISH:

### AQUIFERS:

### WATER LEVEL:

12 feet below surface

PUMPING EQUIPMENT: Type jet H.P. 1/2  
Capacity 10 G.P.M.

### WELL TESTS:

Drawdown 53 ft. after 10 hours G.P.M.  
Drawdown \_\_\_\_\_ ft. after \_\_\_\_\_ hours G.P.M.

USE OF WATER Irrigation Temp. °F. 19  
SOURCE OF INFORMATION Well Registration Statement Cert. # GR-3668

DRILLER or DIGGER \_\_\_\_\_

### ADDITIONAL DATA:

Log  Water Level Measurements \_\_\_\_\_ Chemical Analysis \_\_\_\_\_ Aquifer Test \_\_\_\_\_

### REMARKS:

Log	Thickness
Top soil	10
Sand	65
White clay	26