

STATE ENGINEER  
Salem, Oregon

WASH  
2 418

# Well Record


STATE WELL NO. 1N/3W - 31G  
COUNTY WASHINGTON  
~~APPLICATION NO:~~ GR-2014

OWNER: Dr. Hugh D. Stites MAILING ADDRESS: 2517 26th Ave.

LOCATION OF WELL: Owner's No. \_\_\_\_\_ CITY AND STATE: Forest Grove, Oregon

SW 1/4 NE 1/4 Sec. 31 T. 1 N. S., R. 3 W. W.M.

Bearing and distance from section or subdivision corner S 74° 36' E, 1662.52'

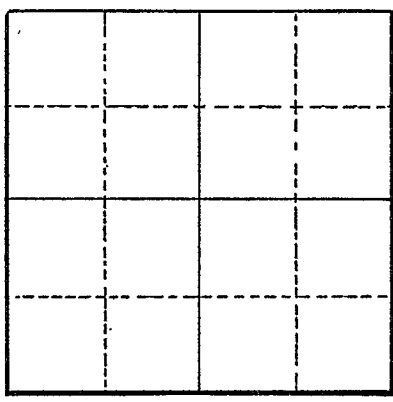

Section \_\_\_\_\_

Altitude at well \_\_\_\_\_

TYPE OF WELL: Drilled Date Constructed 1950

Depth drilled 120 Depth cased \_\_\_\_\_

CASING RECORD:

FINISH:

AQUIFERS:

WATER LEVEL: 80-feet

PUMPING EQUIPMENT: Type Fairbanks Morse H.P. 1.5  
Capacity 350 G.P.M.

WELL TESTS:  
Drawdown \_\_\_\_\_ ft. after \_\_\_\_\_ hours Pumping 300 G.P.M.  
Drawdown \_\_\_\_\_ ft. after \_\_\_\_\_ hours \_\_\_\_\_ G.P.M.

USE OF WATER Irrigation Temp. \_\_\_\_\_ °F. \_\_\_\_\_, 19\_\_\_\_

SOURCE OF INFORMATION GR-1942  
DRILLER or DIGGER Blair Drilling Co., Forest Grove, Oregon

ADDITIONAL DATA:  
Log \_\_\_\_\_ Water Level Measurements \_\_\_\_\_ Chemical Analysis \_\_\_\_\_ Aquifer Test \_\_\_\_\_

REMARKS: