

STATE ENGINEER  
Salem, Oregon

WASH  
6425

# Well Record

STATE WELL NO. 1N/3W-32G  
COUNTY Washington  
APPLICATION NO. \_\_\_\_\_

OWNER: Herbert B. Sahnaw

MAILING ADDRESS: Rt. 2, Box 169


LOCATION OF WELL: Owner's No. \_\_\_\_\_

CITY AND STATE: Forest Grove, Oregon

SW 1/4 NE 1/4 Sec. 32 T. 1 N. 3 R. 3 W., W.M.

Bearing and distance from section or subdivision corner \_\_\_\_\_

Altitude at well \_\_\_\_\_

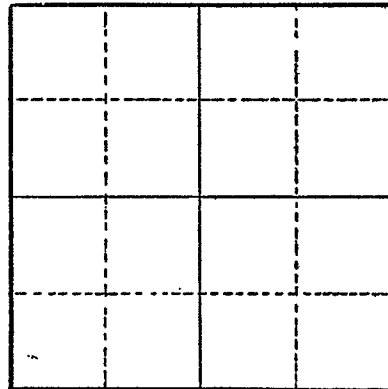

Section 32

TYPE OF WELL: Drilled Date Constructed 1953

Depth drilled 65 ft. Depth cased 65 ft.

### CASING RECORD:

8 inch from 0 to 55 ft.  
6 inch from 55 to 65 ft.

### FINISH:

Perforated from top to bottom.

### AQUIFERS:

### WATER LEVEL:

Top of well

PUMPING EQUIPMENT: Type Jet H.P. 3  
Capacity 50 G.P.M.

### WELL TESTS:

Drawdown 25 ft. after \_\_\_\_\_ hours 50 G.P.M.  
Drawdown 55 ft. after \_\_\_\_\_ hours 40 G.P.M.

USE OF WATER Irrigation Temp. \_\_\_\_\_ °F., 19 \_\_\_\_\_

SOURCE OF INFORMATION Belated registration statement

DRILLER or DIGGER Lee Barton

### ADDITIONAL DATA:

Log \_\_\_\_\_ Water Level Measurements \_\_\_\_\_ Chemical Analysis \_\_\_\_\_ Aquifer Test \_\_\_\_\_

### REMARKS:

Irrigation of 24.4 acres