

STATE ENGINEER
Salem, Oregon

WASH
6427

Well Record

STATE WELL NO. 1N/3W-32M
COUNTY Washington
APPLICATION NO. GR-1314


GR- 1270

OWNER: Dwight L. McCue Mailing ADDRESS: 2247 Maple St.

LOCATION OF WELL: Owner's No. #1 CITY AND STATE: Forest Grove, Oregon

NW 1/4 SW 1/4 Sec. 32 T. 1 N. S. R. 3 W., W.M.

Bearing and distance from section or subdivision corner S43°30'E, 1250' from W^{1/4} cor. Sec. 32.

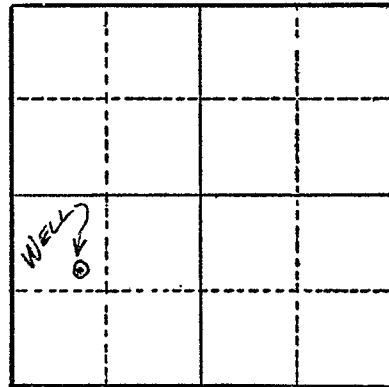

Section 32

Altitude at well 120 ft.

TYPE OF WELL: Drilled Date Constructed 1944

Depth drilled 54 ft. Depth cased 54 ft.

CASING RECORD:
16 inch

FINISH:
Perforated: 1/4 in. holes spaced 2 in. apart from 44 to 54 ft.

AQUIFERS:

WATER LEVEL:
14 ft.

PUMPING EQUIPMENT: Type F. M. Jet H.P. 1
Capacity 30 G.P.M.

WELL TESTS:
Drawdown 15 ft. after 35 hours G.P.M.
Drawdown ft. after hours G.P.M.

USE OF WATER Irrigation Temp. °F., 19

SOURCE OF INFORMATION G. R. Record

DRILLER or DIGGER Jenkins

ADDITIONAL DATA:
Log Water Level Measurements Chemical Analysis Aquifer Test

REMARKS:

Log: Top soil	0 to 1 1/2 ft.
SAND Blue clay	1 1/2 to 25 ft.
Sand & blue clay	25 to 29 ft.
Sand EXPOSED	29 to 35 ft.
Sand & blue clay	35 to 43 ft.
Sand	43 to 53 ft.

Irrigation of 2.4 acres.