

WASH 6428

STATE ENGINEER  
Salem, Oregon

WASH  
6428

Well Record

GR- 1453


STATE WELL NO. 1N/3W-32P  
COUNTY Washington  
APPLICATION NO. GR- 1277

OWNER: Paul J. & Tillie M. Senke MAILING ADDRESS: Rt. 2

LOCATION OF WELL: Owner's No. #1 CITY AND STATE: Forest Grove, Oregon

SE 1/4 SW 1/4 Sec. 32 T. 1 N. R. 3 W., W.M.

Bearing and distance from section or subdivision corner N. 84° 42' W. 2722.61' from SE cor. Sec. 32.

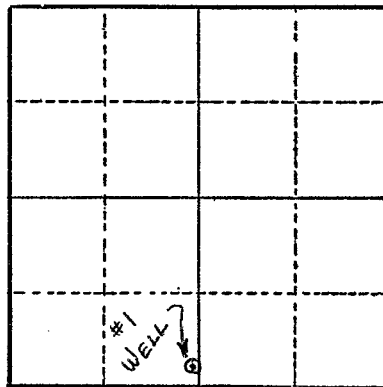

Section 32

Altitude at well 200'

TYPE OF WELL: Drilled Date Constructed 1940

Depth drilled 285' Depth cased 285'

CASING RECORD:  
12"

FINISH:

AQUIFERS:

WATER LEVEL:  
15 ft.

PUMPING EQUIPMENT: Type Pacific H.P. 5  
Capacity 60 G.P.M.

WELL TESTS:  
Drawdown ft. after hours G.P.M.  
Drawdown ft. after hours G.P.M.

USE OF WATER Irrigation Temp. °F. 19

SOURCE OF INFORMATION G. R. Record

DRILLER or DIGGER A.M. Jannsen

ADDITIONAL DATA:  
Log N.A. Water Level Measurements Chemical Analysis Aquifer Test

REMARKS:  
Irrigation of 3.44 acres.



Oregon Water Resources Department
725 Summer Street NE, Suite A
Salem Oregon 97301
(503) 986-0900
www.oregon.gov/owrd

Application for
Well ID Number

RECEIVED

MAY 16 2019

Do not complete if the well already has a Well Identification Number.

OWRD

I. OWNER INFORMATION

Current Owner Name (please print): Forest Villa Apartments
Mailing Address: 2131 Quince Street
City, State, Zip: Forest Grove, OR 97116
Mail Well ID to: [ ] SAME AS ABOVE [X] In Care Of (C/O)
Name & Address: Managers Office - 2131 Quince Street
City, State, Zip: Forest Grove, OR 97116

II. WELL LOCATION INFORMATION (Please fill out as completely as possible)

Township: 1 (North / South) Range: 3 (East / West) Section: 32 SW 1/4 of the SE 1/4
Tax Lot (usually last 3-5 numbers of Tax Map #): 1100 County Washington
GPS Coordinates:
Street Address of Well, City: 2131 Quince Street, Forest Grove
If the property had a different street address in the past: 2135 Quince Street, Forest Grove

III. GENERAL WELL INFORMATION (Please fill out as completely as possible, AND attach copy of Well Report, if available)

Use of Well (domestic, irrigation, commercial, industrial, monitoring): Irrigation
Date Well Constructed (or property built): 1940 Total Well Depth: 285' Casing Diameter: 12"
Owner at time the well was constructed (if known): Paul J & Tillie M. Senko Well Report # (if known): WASH 6428
Other Information:

SUBMITTED BY (please print): Forest Villa Apts
PHONE: 503-357-5144 EMAIL &/or FAX: quince446@gmail.com

Send application to: Oregon Water Resources Department 725 Summer St NE, Suite A, Salem, Oregon 97301; or fax to (503) 986-0902.
Applications are processed in the order they are received, and Well ID Numbers are mailed within 4-5 business days.

For Official Use Only by the Oregon Water Resources Department:

Received Date:

5-16-19

Well Report Number:

WASH 6428

Well Identification #:

L-134047