

WASH
6429

Well Record

OWNER: Masonic & Eastern Star Home MAILING ADDRESS:

LOCATION OF WELL: Owner's No. CITY AND STATE:

..... 1/4 1/4 Sec. T. N. S., R. E. W., W.M.


Bearing and distance from section or subdivision corner

Altitude at well 175 ft.

TYPE OF WELL: drilled. Date Constructed

Depth drilled 177 ft. Depth cased 177 ft.

CASING RECORD: 10 - 8 inch.

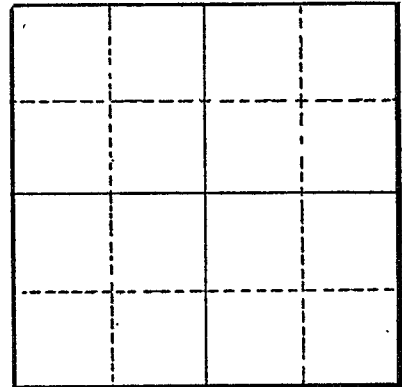

Section

FINISH:

AQUIFERS: Gravel from 5 to 141 ft.

WATER LEVEL: 25 ft. below land surface.

PUMPING EQUIPMENT: Type Jet H.P. Capacity G.P.M.

WELL TESTS: Drawdown ft. after hours G.P.M. Drawdown ft. after hours G.P.M.

USE OF WATER Irrigation Temp. °F., 19

SOURCE OF INFORMATION USGS

DRILLER or DIGGER

ADDITIONAL DATA: Log Water Level Measurements Chemical Analysis Aquifer Test

REMARKS: Water-supply Paper 890 well 22; lower 50 ft. of 8-inch casing perforated; pumped 50 gpm. with 5 ft. drawdown.