

STATE ENGINEER
Salem, Oregon

WASH
6432

Well Record

STATE WELL NO. 1N/3W-32R
COUNTY Washington
APPLICATION NO. GR-3724

OWNER: Orval D. White


MAILING ADDRESS: Route 2, Box 159

LOCATION OF WELL: Owner's No. _____

CITY AND STATE: Forest Grove, Oregon

SE 1/4 SE 1/4 Sec. 32 T. 1 N. 3 R. 3 W., W.M.

Bearing and distance from section or subdivision corner 130' N. and 120' W. of SW cor. Sec. 33

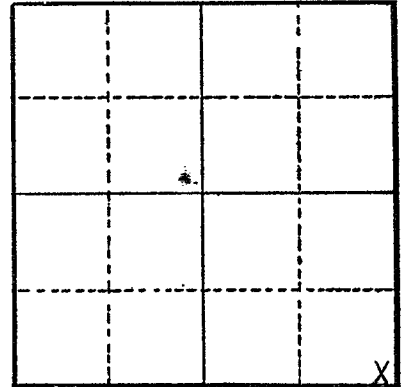

Section 32

Altitude at well _____

TYPE OF WELL: Drilled Date Constructed 1945

Depth drilled 50 feet Depth cased 50 feet

CASING RECORD:

6 inch steel casing set to 50 feet

FINISH:

AQUIFERS:

WATER LEVEL:

1 foot below surface

PUMPING EQUIPMENT: Type Fairbanks Morse H.P. 1
Capacity 11 G.P.M.

WELL TESTS:

| | | | | | | |
|----------|----------|-----------|-------|-------|-----------|--------|
| Drawdown | <u>?</u> | ft. after | _____ | hours | <u>15</u> | G.P.M. |
| Drawdown | _____ | ft. after | _____ | hours | _____ | G.P.M. |

USE OF WATER Irrigation Temp. _____ °F. _____, 19_____

SOURCE OF INFORMATION Well Registration Statement

DRILLER or DIGGER D. D. Parkins

ADDITIONAL DATA:

Log Water Level Measurements _____ Chemical Analysis _____ Aquifer Test _____

REMARKS:

Log:

Brown soil & subsoil
Sand
Blue clay

| Thickness | Depth to Bottom |
|-----------|-----------------|
| 20 | 20 |
| 20 | 40 |
| 10 | 50 |