

STATE ENGINEER
Salem, Oregon

WASH
6433

Well Record

STATE WELL NO. 1N-3W-32R
COUNTY Washington
APPLICATION NO. GR-3342

OWNER: Delmer Kiser


MAILING ADDRESS: Route 2, Box 160

LOCATION OF WELL: Owner's No. Well #1

CITY AND STATE: Forest Grove, Oregon

SE 1/4 SE 1/4 Sec. 32 T. 1 N. S. R. 3 W., W.M.

Bearing and distance from section or subdivision corner 1170' W. and 60' N.

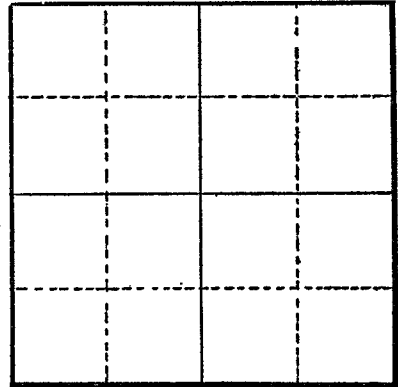

Section

Altitude at well

TYPE OF WELL: drilled Date Constructed 1945

Depth drilled 45' Depth cased 45'

CASING RECORD:
6"

FINISH:

AQUIFERS:

clay, sand

WATER LEVEL:

16'

PUMPING EQUIPMENT: Type Fairbanks Morse H.P. 1

Capacity 18 G.P.M.

WELL TESTS:

Drawdown 2 ft. after hours pumping 10 G.P.M.

Drawdown ft. after hours G.P.M.

USE OF WATER Irrigation Temp. °F., 19

SOURCE OF INFORMATION GR-3095

DRILLER or DIGGER self

ADDITIONAL DATA:

Log Water Level Measurements Chemical Analysis Aquifer Test

REMARKS:

Blue Clay	20	20
Sand	11	31
Blue Clay	14	45